


1 LOCATION OF WATER WELL: Fraction SW Section Number 28 Township Number T 13 S Range Number R 18 W
 County: Ellis

Distance and direction from nearest town or city street address of well if located within city?
1800 E 25th HAYS KS

2 WATER WELL OWNER: MARK NELSON
 RR#, St. Address, Box #: 1800 E 25th Board of Agriculture, Division of Water Resources
 City, State, ZIP Code: HAYS KS 67601 Application Number:

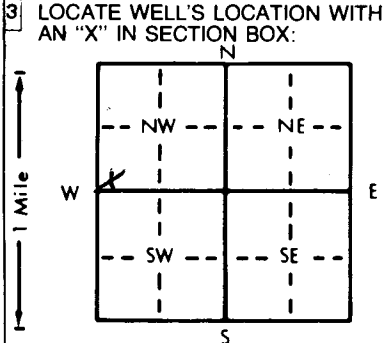

4 DEPTH OF COMPLETED WELL: 53' ft. ELEVATION:
 Depth(s) Groundwater Encountered 1. 32' ft. 2. ft. 3. ft.
 WELL'S STATIC WATER LEVEL: 31' ft. below land surface measured on mo/day/yr
 Pump test data: Well water was ft. after hours pumping gpm
 Est. Yield 307 gpm: Well water was ft. after hours pumping gpm
 Bore Hole Diameter: 10 in. to 53 ft., and in. to ft.
 WELL WATER TO BE USED AS:
 5 Public water supply 8 Air conditioning 11 Injection well
 1 Domestic 3 Feedlot 6 Oil field water supply 9 Dewatering 12 Other (Specify below)
 2 Irrigation 4 Industrial 7 Lawn and garden only 10 Monitoring well
 Was a chemical/bacteriological sample submitted to Department? Yes No ; If yes, mo/day/yr sample was submitted
 Water Well Disinfected? Yes No

5 TYPE OF BLANK CASING USED:
 1 Steel 3 RMP (SR) 5 Wrought iron 8 Concrete tile CASING JOINTS: Glued Clamped
2 PVC 4 ABS 6 Asbestos-Cement 9 Other (specify below) Welded
 7 Fiberglass Threaded
 Blank casing diameter: 5" in. to 53' ft., Dia. in. to ft., Dia. in. to ft.
 Casing height above land surface: 14" in., weight lbs./ft. Wall thickness or gauge No. SDR 26
 TYPE OF SCREEN OR PERFORATION MATERIAL:
 1 Steel 3 Stainless steel 5 Fiberglass 7 PVC 10 Asbestos-cement
 2 Brass 4 Galvanized steel 6 Concrete tile 8 RMP (SR) 11 Other (specify)
 12 None used (open hole)
 SCREEN OR PERFORATION OPENINGS ARE:
 1 Continuous slot 3 Mill slot 5 Gauzed wrapped 8 Saw cut 11 None (open hole)
 2 Louvered shutter 4 Key punched 6 Wire wrapped 9 Drilled holes
 7 Torch cut 10 Other (specify)
 SCREEN-PERFORATED INTERVALS: From 53' ft. to 33' ft. From ft. to ft.
 From ft. to ft. From ft. to ft.
 GRAVEL PACK INTERVALS: From 53' ft. to 30' ft. From ft. to ft.
 From ft. to ft. From ft. to ft.

6 GROUT MATERIAL: 1 Neat cement 2 Cement grout 3 Bentonite 4 Other
 Grout Intervals: From ft. to ft., From ft. to ft., From ft. to ft.
 What is the nearest source of possible contamination:
 1 Septic tank 4 Lateral lines 7 Pit privy 10 Livestock pens 14 Abandoned water well
2 Sewer lines 5 Cess pool 8 Sewage lagoon 11 Fuel storage 15 Oil well/Gas well
 3 Watertight sewer lines 6 Seepage pit 9 Feedyard 12 Fertilizer storage 16 Other (specify below)
 13 Insecticide storage
 Direction from well? WEST How many feet? 40'

FROM	TO	LITHOLOGIC LOG	FROM	TO	PLUGGING INTERVALS
0	2	TOP SOIL			
2	13	DARK BROWN CLAY			
13	23	LIGHT BROWN CLAY			
23	33	FINE SAND			
33	40	MED. SAND & LIMESTONE GRAVEL			
40	49	COARSE GRAVEL			
49	52	CLAY LIMESTONE			
52	53	SHALE			

7 CONTRACTOR'S OR LANDOWNER'S CERTIFICATION: This water well was (1) constructed, (2) reconstructed, or (3) plugged under my jurisdiction and was completed on (mo/day/year) 8/12/90 and this record is true to the best of my knowledge and belief. Kansas Water Well Contractor's License No. 478. This Water Well Record was completed on (mo/day/yr) 8/12/90 under the business name of PLANNONSTIER WATER WELL by (signature) [Signature]

INSTRUCTIONS: Use typewriter or ball point pen. PLEASE PRESS FIRMLY and PRINT clearly. Please fill in blanks, underline or circle the correct answers. Send top three copies to Kansas Department of Health and Environment, Bureau of Water, Topeka, Kansas 66620-7320. Telephone: 913-296-5545. Send one to WATER WELL OWNER and retain one for your records.

OFFICE USE ONLY
T
R
EW
SEC
1/4
1/4
1/4