


WATER WELL RECORD Form WWC-5 KSA 82a-1212

1 LOCATION OF WATER WELL: County: <u>Ellis</u>	Fraction SW <u>1/4</u> SE <u>1/4</u> SE <u>1/4</u>	Section Number <u>28</u>	Township Number T <u>13</u> S	Range Number R <u>18</u> <u>E/W</u>
---	---	-----------------------------	----------------------------------	--

Distance and direction from nearest town or city street address of well if located within city?
106 East 28th Street Hays, Kansas 67601

2 WATER WELL OWNER: Dave Kisner
 RR#, St. Address, Box # : 106 East 28th Street
 City, State, ZIP Code : Hays, Kansas 67601
 Board of Agriculture, Division of Water Resources
 Application Number:

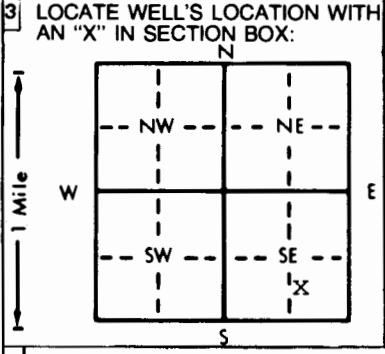

4 DEPTH OF COMPLETED WELL: 88 ft. ELEVATION: Upland
 Depth(s) Groundwater Encountered 1. 58 ft. 2. 58 ft. 3. 58 ft.
 WELL'S STATIC WATER LEVEL 40 ft. below land surface measured on mo/day/yr 2/19/92
 Pump test data: Well water was 39 ft. after 1 hours pumping 20 gpm
 Est. Yield 20 gpm: Well water was 39 ft. after 1 hours pumping 20 gpm
 Bore Hole Diameter 10 in. to 88 ft., and 10 in. to 88 ft.
 WELL WATER TO BE USED AS:
 7 5 Public water supply 8 Air conditioning 11 Injection well
 1 Domestic 3 Feedlot 6 Oil field water supply 9 Dewatering 12 Other (Specify below)
 2 Irrigation 4 Industrial 7 Lawn and garden only 10 Monitoring well
 Was a chemical/bacteriological sample submitted to Department? Yes X No X; If yes, mo/day/yr sample was submitted
 Water Well Disinfected? Yes X No X

5 TYPE OF BLANK CASING USED: 2 5 Wrought iron 8 Concrete tile CASING JOINTS: Glued X Clamped X
 1 Steel 3 RMP (SR) 6 Asbestos-Cement 9 Other (specify below) Welded X
2 PVC 4 ABS 7 Fiberglass Threaded X
 Blank casing diameter 5 in. to 68 ft., Dia 5 in. to 68 ft., Dia 5 in. to 68 ft.
 Casing height above land surface 24 in., weight 2.29 lbs./ft. Wall thickness or gauge No. 26
 TYPE OF SCREEN OR PERFORATION MATERIAL: 7 7 PVC 10 Asbestos-cement
 1 Steel 3 Stainless steel 5 Fiberglass 8 RMP (SR) 11 Other (specify) X
 2 Brass 4 Galvanized steel 6 Concrete tile 9 ABS 12 None used (open hole)
 SCREEN OR PERFORATION OPENINGS ARE: 8 5 Gauzed wrapped 8 Saw cut 11 None (open hole)
 1 Continuous slot 3 Mill slot 6 Wire wrapped 9 Drilled holes
 2 Louvered shutter 4 Key punched 7 Torch cut 10 Other (specify) X
 SCREEN-PERFORATED INTERVALS: From 88 ft. to 68 ft., From 88 ft. to 68 ft.
 From 88 ft. to 68 ft., From 88 ft. to 68 ft.
 GRAVEL PACK INTERVALS: From 20 ft. to 88 ft., From 20 ft. to 88 ft.
 From 20 ft. to 88 ft., From 20 ft. to 88 ft.

6 GROUT MATERIAL: 1 1 Neat cement 2 Cement grout 3 Bentonite 4 Other X
 Grout Intervals: From 0 ft. to 20 ft., From 0 ft. to 20 ft., From 0 ft. to 20 ft.
 What is the nearest source of possible contamination: None
 1 Septic tank 4 Lateral lines 7 Pit privy 10 Livestock pens 14 Abandoned water well
 2 Sewer lines 5 Cess pool 8 Sewage lagoon 11 Fuel storage 15 Oil well/Gas well
 3 Watertight sewer lines 6 Seepage pit 9 Feedyard 12 Fertilizer storage 16 Other (specify below)
 13 Insecticide storage

Direction from well? _____ How many feet? _____

FROM	TO	LITHOLOGIC LOG	FROM	TO	PLUGGING INTERVALS
0	3	Topsoil			
3	20	Gumbo			
20	30	Soft clay			
30	32	Sand			
32	58	Soft clay			
58	82	Sand			
82	88	Shale			

7 CONTRACTOR'S OR LANDOWNER'S CERTIFICATION: This water well was (1) constructed, (2) reconstructed, or (3) plugged under my jurisdiction and was completed on (mo/day/year) 2/19/92 and this record is true to the best of my knowledge and belief. Kansas Water Well Contractor's License No. 199 This Water Well Record was completed on (mo/day/yr) 2/25/92 under the business name of Karst Water Well Drilling & Service, Inc. by (signature) [Signature]

INSTRUCTIONS: Use typewriter or ball point pen. PLEASE PRESS FIRMLY and PRINT clearly. Please fill in blanks, underline or circle the correct answers. Send top three copies to Kansas Department of Health and Environment, Bureau of Water, Topeka, Kansas 66620-0001. Telephone: 913-296-5545. Send one to WATER WELL OWNER and retain one for your records.