


1 LOCATION OF WATER WELL: Fraction NE 1/4 SE 1/4 SE 1/4 Section Number 29 Township Number T 13 S Range Number R 18 E/W
 County: Ellis

Distance and direction from nearest town or city street address of well if located within city?

3104 Eldorado LN Hays Ks

2 WATER WELL OWNER: Elmer Staab Board of Agriculture, Division of Water Resources
 RR#, St. Address, Box #: 3104 Eldorado Lane Application Number:
 City, State, ZIP Code: Hays Ks 67601

3 LOCATE WELL'S LOCATION WITH AN "X" IN SECTION BOX: 4 DEPTH OF COMPLETED WELL 98 ft. ELEVATION: _____

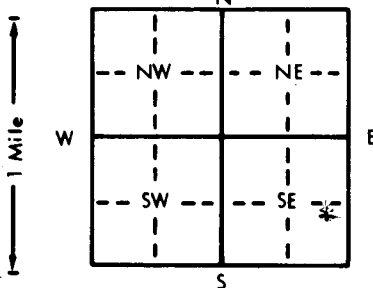

Depth(s) Groundwater Encountered 1. 75 ft. 2. _____ ft. 3. _____ ft.
 WELL'S STATIC WATER LEVEL 65 ft. below land surface measured on mo/day/yr 10/16/85
 Pump test data: Well water was 33 ft. after 1 hours pumping 18 gpm
 Est. Yield 25 gpm: Well water was _____ ft. after _____ hours pumping _____ gpm
 Bore Hole Diameter 10 in. to _____ ft., and _____ in. to _____ ft.
 WELL WATER TO BE USED AS: 5 Public water supply 8 Air conditioning 11 Injection well
 1 Domestic 3 Feedlot 6 Oil field water supply 9 Dewatering 12 Other (Specify below)
 2 Irrigation 4 Industrial 7 Lawn and garden only 10 Observation well
 Was a chemical/bacteriological sample submitted to Department? Yes _____ No *; If yes, mo/day/yr sample was submitted
 Water Well Disinfected? Yes * No

5 TYPE OF BLANK CASING USED: 5 Wrought iron 8 Concrete tile CASING JOINTS: Glued Clamped _____
 1 Steel 3 RMP (SR) 6 Asbestos-Cement 9 Other (specify below) Welded _____
2 PVC 4 ABS 7 Fiberglass _____ Threaded _____

Blank casing diameter 5 in. to _____ ft., Dia _____ in. to _____ ft., Dia _____ in. to _____ ft.
 Casing height above land surface 18 in., weight _____ lbs./ft. Wall thickness or gauge No. SDR 21

TYPE OF SCREEN OR PERFORATION MATERIAL: 7 PVC 10 Asbestos-cement
 1 Steel 3 Stainless steel 5 Fiberglass 8 RMP (SR) 11 Other (specify) _____
 2 Brass 4 Galvanized steel 6 Concrete tile 9 ABS 12 None used (open hole)

SCREEN OR PERFORATION OPENINGS ARE: 5 Gauzed wrapped 8 Saw cut 11 None (open hole)
 1 Continuous slot 3 Mill slot 6 Wire wrapped 9 Drilled holes
 2 Louvered shutter 4 Key punched 7 Torch cut 10 Other (specify) _____

SCREEN-PERFORATED INTERVALS: From 58 ft. to 98 ft., From _____ ft. to _____ ft.
 From _____ ft. to _____ ft., From _____ ft. to _____ ft.
 GRAVEL PACK INTERVALS: From 50 ft. to 98 ft., From _____ ft. to _____ ft.
 From _____ ft. to _____ ft., From _____ ft. to _____ ft.

6 GROUT MATERIAL: 1 ~~Neat cement~~ 2 Cement grout 3 Bentonite 4 Other _____
 Grout Intervals: From 5 ft. to 15 ft., From _____ ft. to _____ ft., From _____ ft. to _____ ft.

What is the nearest source of possible contamination:
 1 Septic tank 4 Lateral lines 7 Pit privy 10 Livestock pens 14 Abandoned water well
 2 Sewer lines 5 Cess pool 8 Sewage lagoon 11 Fuel storage 15 Oil well/Gas well
3 Watertight sewer lines 6 Seepage pit 9 Feedyard 12 Fertilizer storage 16 Other (specify below)
 13 Insecticide storage _____
 Direction from well? South How many feet? 75

FROM	TO	LITHOLOGIC LOG	FROM	TO	LITHOLOGIC LOG
0	20	top soil			
20	58	brown clay			
58	64	brown clay mixed with layers of fine grey sand			
64	75	fine grey sand			
75	80	blue clay			
80	96	med to coarse red & grey sand			
96	98	shale			

7 CONTRACTOR'S OR LANDOWNER'S CERTIFICATION: This water well was (1) constructed, (2) reconstructed, or (3) plugged under my jurisdiction and was completed on (mo/day/year) 10/16/85 and this record is true to the best of my knowledge and belief. Kansas Water Well Contractor's License No. 276 This Water Well Record was completed on (mo/day/yr) 10/16/85 under the business name of Luea Water Well Drilling by (signature) Jahn Dues

INSTRUCTIONS: Use typewriter or ball point pen, PLEASE PRESS FIRMLY and PRINT clearly. Please fill in blanks, underline or circle the correct answers. Send top three copies to Kansas Department of Health and Environment, Division of Environment, Environmental Geology Section, Topeka, KS 66620. Send one to WATER WELL OWNER and retain one for your records.