USE TYPEWRITER OR BALL POINT PEN-PRESS FIRMLY, PRINT CLEARLY.

WATER WELL RECORD
KSA 82a-1201-1215

Kansas Department of Health and Environment-Division of Environment
(Water well Contractors)
Topeka, Kansas 66620

| 1. Location of well: | County | Fraction | Section number | Township number | Range number |
|---|---|---|---|---|---|
| | Ellis | SE 1/4 NE 1/4 SE 1/4 | 29 | T 13 S | R 18 E (W) |

2. Distance and direction from nearest town or city:
Street address of well location if in city: El Dorado

3. Owner of well: Virgil Jacobs
R.R. or street: El Dorado
City, state, zip code: Hays, Ks. 67601

4. Locate with "X" in section below:

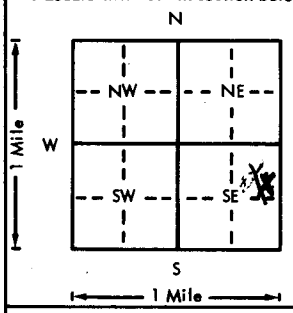


Sketch map:

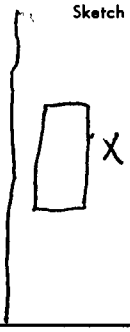


6. Bore hole dia. 6 in. Completion date 3-28-76
Well depth 71 ft.

7. __ Cable tool X Rotary __ Driven __ Dug
__ Hollow rod X Jetted __ Bored __ Reverse rotary

8. Use: __ Domestic __ Public supply __ Industry
X Irrigation __ Air conditioning __ Stock
X Lawn __ Oil field water __ Other

9. Casing: Material plst. Height: (Above) or below
Threaded glued welded Surface 14 in.
RMP PVC Weight lbs./ft.
Dia. 5 in. to 71 ft. depth Wall Thickness: inches or
Dia. in. to ft. depth gage No. 200

| 5. Type and color of material | From | To |
|---|---|---|
| topsoil | 0 | 5 |
| Clay | 5 | 25 |
| Sand, fine | 25 | 52 |
| Water sand | 52 | 71 |
| Blue Shale | 71 | |

(Use a second sheet if needed)

10. Screen: Manufacturer's name Jess + Lowell
Type RMP Dia. 5"
Slot/gauze .06 Length 10'
Set between 61 ft. and 71 ft.
ft. and ft.
Gravel pack? yes Size range of material 1/2

11. Static water level: mo./day/yr.
50 ft. below land surface Date 3-28-76

12. Pumping level below land surfaces:
65 ft. after 2 hrs. pumping 13 g.p.m.
ft. after hrs. pumping g.p.m.
Estimated maximum yield 300 g.p.m.

13. Water sample submitted: mo./day/yr.
__ Yes X No Date

14. Well head completion:
__ Pitless adapter 18 Inches above grade

15. Well grouted? yes
With: __ Neat cement __ Bentonite X Cancrete
Depth: From surf ft. to 12 ft.

16. Nearest source of possible contamination:
ft. 15 Direction S Type SEWER
Well disinfected upon completion? X Yes __ No

17. Pump: __ Not installed
Manufacturer's name Fairbanks
Model number HP 3/4 Volts 220
Length of drop pipe 68 ft. capacity 25 g.p.m.
Type:
X Submersible __ Turbine
__ Jet __ Reciprocating
__ Centrifugal __ Other

18. Elevation:
Topography:
__ Hill level
__ Slope
__ Upland
__ Valley

19. Remarks:

20. Water well contractor's certification:
This well was drilled under my jurisdiction and this report is true to the best of my knowledge and belief.
R. F. Coupal 266
Business name License No.
Address 616 E. 6th Hays, Ks
Signed Raymond F. Coupal Date
Authorized representative 3-28-76

T 13 R 18 E (W) Sec 29 1/4 SE 1/4 NE 1/4 SE 1/4

Forward the white, blue and pink copies to the Department of Health and Environment

Form WWC-5

MI-1023