USE TYPEWRITER OR BALL POINT PEN-PRESS FIRMLY, PRINT CLEARLY.

T R EW sec 1/4 1/4 1/4 No.

WATER WELL RECORD
KSA 82a-1201-1215

NW¼NE¼SE¼

Kansas State Dept. Of Health
(Water Well Contractors)
Forbes-Bldg. 740
Topeka, Kansas 66620

1 Location of well:	County	Township name	Fraction	Section number	Town number	Range number
	Ellis	Big Creek	SE. ¼	29	T13S	R18W

Distance and direction from nearest town or city:

Street address of well location if in city: 1108 country Club Dr. Hays, Kansas

3 Owner of well: Dick Compton

Address: 1108 Country Club. Dr. Hays. Kansas

Locate with "X" in section below:

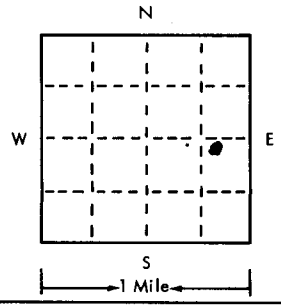

Sketch map:

4 Well depth: 75 ft. Date of completion 4-25-75
Well diameter 10 in.

5 ☐ Cable tool ☒ Rotary ☐ Driven ☐ Dug
☐ Hollow rod ☐ Jetted ☐ Bored ☐ Reverse rotary

6 Use: ☐ Domestic ☐ Public supply ☐ Industry
☐ Irrigation ☐ Air conditioning ☐ Commercial
☐ Test well ☒ Lawn

7 Casing: Material Plastic Height: above/below
Threaded ☐ Welded ☐ Surface 12 in.
Diam. after screens Weight ____ lbs./ft.
____ in. to ____ ft. depth Drive shoe? ☐ Yes ☐ No
5 in. to 55 ft. depth 200-21-35-1/4" thick

2

Type and color of material	From	To
Dark dirt	0	12
Black dirt mixed Yello Gumbo	12	55
Red fine sand	55	59
Red coarse Sand + Gravel 1/8 - 1/4 size	59	73
Shale (Blue)	73	75
(use a second sheet if needed)		

8 Screen:
Manufacturer Jess + Lowell
Type Plastic Dia. 5
Slot gauze 40 Length 10 ft
Set between 55 ft. and 75 ft.
Fittings:
Gravel pack ☒ Yes ☐ No Size range of material 1/8 - 3/8

9 Static water level:
53 ft. below land surface Date 4-25-75

10 Pumping level below land surfaces:
____ ft. after ____ hrs. pumping ____ g.p.m.
____ ft. after ____ hrs. pumping ____ g.p.m.
Estimated maximum yield 7 g.p.m.

11 Water sample submitted:
☐ Yes ☒ No Date ____

12 Well head completion:
☒ Pitless adapter 12 Inches above grade

13 Well grouted? ☒ Yes ☐ No
☒ Neat cement ☐ Bentonite ☐ ____
Depth: From 0 ft. to 10 ft.

14 Nearest source of possible contamination:
ft. 12 Direction East Type Sewer line
Well disinfected upon completion? ☒ Yes ☐ No

15 Pump: ☒ Not installed
Manufacturer's name ____
Model number ____ HP ____ Volts ____
Length of drop pipe ____ ft. capacity ____ g.m.p.
Type:
☐ Submersible ☐ Turbine
☐ Jet ☐ Reciprocating
☐ Certrifugal ☐ Other

16 Remarks: elevation

Topography:
☐ Hill
☐ Slope
☒ Upland
☐ Valley

17 Water well contractor's certification:
This well was drilled under my jurisdiction and this report is true to the best of my knowledge and belief.
Luca Water Well Drilling
Business name License No.
Address 503 Monroe 276
Signed John Luca Date 4-25-75
Authorized representative
Ellis Kansas

Forward the white, blue and pink copies to the Kansas State Dept. Of Health.

Form WWC-5

677-H