


1] LOCATION OF WATER WELL: Fraction NW 1/4 SE 1/4 SE 1/4 Section Number 29 Township Number T 13 S Range Number R 18 E
 County: ELLIS

Distance and direction from nearest town or city street address of well if located within city?
204 W 38 Hays Kc.

2] WATER WELL OWNER: GARY WEATHERBEE
 RR#, St. Address, Box # : 204 W 38
 City, State, ZIP Code : HAYS KS 67601
 Board of Agriculture, Division of Water Resources
 Application Number:

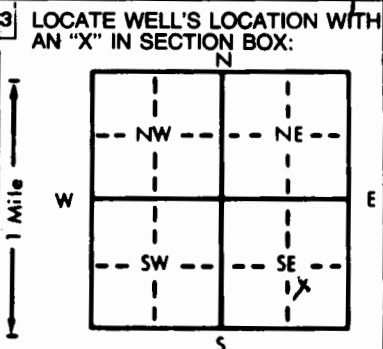

4] DEPTH OF COMPLETED WELL... 60 ft. ELEVATION:
 Depth(s) Groundwater Encountered 1. 48 ft. 2. ft. 3. ft.
 WELL'S STATIC WATER LEVEL 58 ft. below land surface measured on mo/day/yr 9/4/87
 Pump test data: Well water was 1 1/2 ft. after 1 1/2 hours pumping 14 gpm
 Est. Yield 14 gpm: Well water was ft. after hours pumping gpm
 Bore Hole Diameter. 1.0 in. to ft., and in. to ft.
 WELL WATER TO BE USED AS:
 Domestic 3 Feedlot 6 Oil field water supply 9 Dewatering 12 Other (Specify below)
 2 Irrigation 4 Industrial 7 Lawn and garden only 10 Observation well
 Was a chemical/bacteriological sample submitted to Department? Yes..... No.....; If yes, mo/day/yr sample was submitted
 Water Well Disinfected Yes No

5] TYPE OF BLANK CASING USED:
 1 Steel 3 RMP (SR) 5 Wrought iron 8 Concrete tile CASING JOINTS Glued Clamped
 PVC 4 ABS 6 Asbestos-Cement 9 Other (specify below) Welded
 7 Fiberglass Threaded
 Blank casing diameter 5 in. to ft., Dia in. to ft., Dia in. to ft.
 Casing height above land surface 20 in., weight lbs./ft. Wall thickness or gauge No. SDA 26
 TYPE OF SCREEN OR PERFORATION MATERIAL:
 1 Steel 3 Stainless steel 5 Fiberglass 8 RMP (SR) 10 Asbestos-cement
 2 Brass 4 Galvanized steel 6 Concrete tile 9 ABS 11 Other (specify)
 12 None used (open hole)
 SCREEN OR PERFORATION OPENINGS ARE:
 1 Continuous slot 3 Mill slot 5 Gauzed wrapped Saw cut 11 None (open hole)
 2 Louvered shutter 4 Key punched 6 Wire wrapped 9 Drilled holes
 7 Torch cut 10 Other (specify)
 SCREEN-PERFORATED INTERVALS: From 40 ft. to 60 ft., From ft. to ft.
 GRAVEL PACK INTERVALS: From 40 ft. to 60 ft., From ft. to ft.

6] GROUT MATERIAL: 1 Neat cement Cement grout 3 Bentonite 4 Other
 Grout intervals: From 5 ft. to 25 ft., From ft. to ft., From ft. to ft.
 What is the nearest source of possible contamination:
 1 Septic tank 4 Lateral lines 7 Pit privy 10 Livestock pens 14 Abandoned water well
 2 Sewer lines 5 Cess pool 8 Sewage lagoon 11 Fuel storage 15 Oil well/Gas well
 3 Watertight sewer lines 6 Seepage pit 9 Feedyard 12 Fertilizer storage 16 Other (specify below)
 13 Insecticide storage
 Direction from well? North How many feet? 40

FROM	TO	LITHOLOGIC LOG	FROM	TO	LITHOLOGIC LOG
0	12	TOP SOIL			
12	45	BROWN CLAY			
45	58	MED TO FINE GRAY SAND			
58	60	SHALE			

7] CONTRACTOR'S OR LANDOWNER'S CERTIFICATION: This water well was (1) constructed (2) reconstructed or (3) plugged under my jurisdiction and was completed on (mo/day/year) 9/4/87 and this record is true to the best of my knowledge and belief. Kansas Water Well Contractor's License No. 276 This Water Well Record was completed on (mo/day/yr) 9/4/87 under the business name of LUKA WATER WELL DRILLING by (signature) [Signature]