


1 LOCATION OF WATER WELL: County: <u>Ellis</u>	Fraction SW 1/4 NE 1/4 NW 1/4	Section Number <u>29</u>	Township Number T <u>13</u> S	Range Number R <u>18</u> <u>W</u>
---	----------------------------------	-----------------------------	----------------------------------	--------------------------------------

Distance and direction from nearest town or city street address of well if located within city?
3121 Thunderbird Circle Hays, Kansas

2 WATER WELL OWNER: Ray Schlitter
RR#, St. Address, Box # : 3121 Thunderbird Circle
City, State, ZIP Code : Hays, Kansas 67601
Board of Agriculture, Division of Water Resources
Application Number:

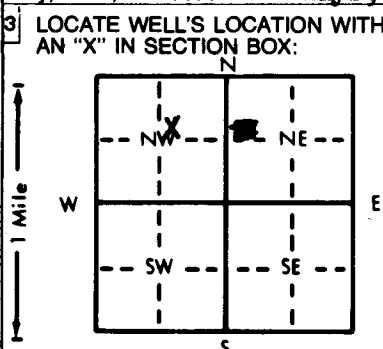

4 DEPTH OF COMPLETED WELL: 76 ft. ELEVATION: Upland
Depth(s) Groundwater Encountered 1. 58 ft. 2. . ft. 3. . ft.
WELL'S STATIC WATER LEVEL . . . 55 ft. below land surface measured on mo/day/yr 12/10/88
Pump test data: Well water was 57 ft. after 4 hours pumping 25 gpm
Est. Yield . . . 25 gpm: Well water was . . . ft. after . . . hours pumping . . . gpm
Bore Hole Diameter . . . 10 in. to . . . 76 ft., and . . . in. to . . . ft.
WELL WATER TO BE USED AS: 7 5 Public water supply 8 Air conditioning 11 Injection well
1 Domestic 3 Feedlot 6 Oil field water supply 9 Dewatering 12 Other (Specify below)
2 Irrigation 4 Industrial 7 Lawn and garden only 10 Observation well
Was a chemical/bacteriological sample submitted to Department? Yes No ; If yes, mo/day/yr sample was submitted
Water Well Disinfected? Yes No

5 TYPE OF BLANK CASING USED: 2 5 Wrought iron 8 Concrete tile CASING JOINTS: Glued Clamped
1 Steel 3 RMP (SR) 6 Asbestos-Cement 9 Other (specify below) Welded
2 PVC 4 ABS 7 Fiberglass Threaded
Blank casing diameter . . . 5 in. to . . . 56 ft., Dia . . . in. to . . . ft., Dia . . . in. to . . . ft.
Casing height above land surface . . . 18 in., weight . . . 160 lbs./ft. Wall thickness or gauge No. . . . 26
TYPE OF SCREEN OR PERFORATION MATERIAL: 7 7 PVC 10 Asbestos-cement
1 Steel 3 Stainless steel 5 Fiberglass 8 RMP (SR) 11 Other (specify)
2 Brass 4 Galvanized steel 6 Concrete tile 9 ABS 12 None used (open hole)
SCREEN OR PERFORATION OPENINGS ARE: 8 5 Gauzed wrapped 8 Saw cut 11 None (open hole)
1 Continuous slot 3 Mill slot 6 Wire wrapped 9 Drilled holes
2 Louvered shutter 4 Key punched 7 Torch cut 10 Other (specify)
SCREEN-PERFORATED INTERVALS: From . . . 56 ft. to . . . 76 ft., From . . . ft. to . . . ft.
From . . . ft. to . . . ft., From . . . ft. to . . . ft.
GRAVEL PACK INTERVALS: From . . . 20 ft. to . . . 76 ft., From . . . ft. to . . . ft.
From . . . ft. to . . . ft., From . . . ft. to . . . ft.

6 GROUT MATERIAL: 1 1 Neat cement 2 Cement grout 3 Bentonite 4 Other
Grout Intervals: From 0 ft. to . . . 20 ft., From . . . ft. to . . . ft., From . . . ft. to . . . ft.
What is the nearest source of possible contamination: NONE
1 Septic tank 4 Lateral lines 7 Pit privy 10 Livestock pens 14 Abandoned water well
2 Sewer lines 5 Cess pool 8 Sewage lagoon 11 Fuel storage 15 Oil well/Gas well
3 Watertight sewer lines 6 Seepage pit 9 Feedyard 12 Fertilizer storage 16 Other (specify below)
13 Insecticide storage
Direction from well? How many feet?

FROM	TO	LITHOLOGIC LOG	FROM	TO	LITHOLOGIC LOG
0	4	Topsoil			
4	20	Clay			
20	28	Clay and sand			
28	36	Sand			
36	45	Clay			
45	58	Sandy clay			
58	70	Gravel			
70	76	Shale			

7 CONTRACTOR'S OR LANDOWNER'S CERTIFICATION: This water well was (1) constructed, (2) reconstructed, or (3) plugged under my jurisdiction and was completed on (mo/day/year) 12/10/88 and this record is true to the best of my knowledge and belief. Kansas Water Well Contractor's License No. 199 This Water Well Record was completed on (mo/day/yr) 12/20/88 under the business name of Karst Water Well Drilling & Service Inc. by (signature) [Signature]

INSTRUCTIONS: Use typewriter or ball point pen. PLEASE PRESS FIRMLY and PRINT clearly. Please fill in blanks, underline or circle the correct answers. Send top three copies to Kansas Department of Health and Environment, Office of Oil Field and Environmental Geology, Regulation and Permitting Section, Topeka, Kansas 66620-7500, Telephone: 913-862-9360. Send one to WATER WELL OWNER and retain one for your records.