


1 LOCATION OF WATER WELL: County: Ellis	Fraction SW 1/4 SE 1/4 NW 1/4	Section Number 29	Township Number T 13 S	Range Number R 18 E/W
--	----------------------------------	----------------------	---------------------------	--------------------------

Distance and direction from nearest town or city street address of well if located within city?
 Approximately 1/8 mile west of Hays

2 WATER WELL OWNER: Hays, City of
 RR#, St. Address, Box # : P.O. Box 490
 City, State, ZIP Code : Hays, KS 67601
 Board of Agriculture, Division of Water Resources
 Application Number: N/A

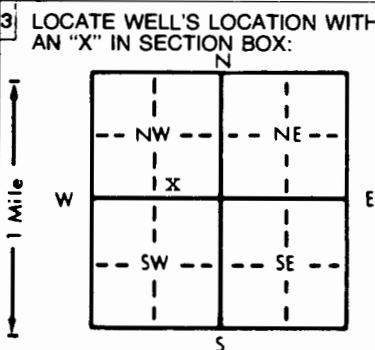

4 DEPTH OF COMPLETED WELL... 61... ft. ELEVATION: unknown

Depth(s) Groundwater Encountered 1. ft. 2. ft. 3. ft.

WELL'S STATIC WATER LEVEL . 45.57... ft. below land surface measured on mo/day/yr . 10-28-92

Pump test data: Well water was not ch'd. ft. after hours pumping gpm

Est. Yield gpm: Well water was ft. after hours pumping gpm

Bore Hole Diameter . . . 8 . in. to . . . 65 ft., and in. to ft.

WELL WATER TO BE USED AS: 5 Public water supply 8 Air conditioning 11 Injection well
 1 Domestic 3 Feedlot 6 Oil field water supply 9 Dewatering 12 Other (Specify below)
 2 Irrigation 4 Industrial 7 Lawn and garden only 10 Monitoring well

Was a chemical/bacteriological sample submitted to Department? Yes.....No.....x.....; If yes, mo/day/yr sample was submitted
 Water Well Disinfected? Yes No x

5 TYPE OF BLANK CASING USED:

1 Steel	3 RMP (SR)	6 Asbestos-Cement	9 Other (specify below)	CASING JOINTS: Glued .x. Clamped
2 PVC	4 ABS	7 Fiberglass		Welded
				Threaded

Blank casing diameter 4 in. to 49 ft., Dia in. to ft., Dia in. to ft.

Casing height above land surface 24 in., weight 2.07 lbs./ft. Wall thickness or gauge No. . . 237

TYPE OF SCREEN OR PERFORATION MATERIAL:

1 Steel	3 Stainless steel	5 Fiberglass	8 RMP (SR)	10 Asbestos-cement
2 Brass	4 Galvanized steel	6 Concrete tile	9 ABS	11 Other (specify)
				12 None used (open hole)

SCREEN OR PERFORATION OPENINGS ARE:

1 Continuous slot	3 Mill slot	5 Gauzed wrapped	8 Saw cut	11 None (open hole)
2 Louvered shutter	4 Key punched	6 Wire wrapped	9 Drilled holes	
		7 Torch cut	10 Other (specify)	

SCREEN-PERFORATED INTERVALS: From 49 ft. to 59 ft., From ft. to ft.

GRAVEL PACK INTERVALS: From 44 ft. to 65 ft., From ft. to ft.

6 GROUT MATERIAL: 1 Neat cement 2 Cement grout 3 Bentonite 4 Other . 75% Gravel Pack and 25% Bentonite Holeplug

Grout Intervals: From 0 ft. to 16 ft., From ft. to ft., From ft. to 44 ft.

What is the nearest source of possible contamination:

1 Septic tank	4 Lateral lines	7 Pit privy	10 Livestock pens	14 Abandoned water well
2 Sewer lines	5 Cess pool	8 Sewage lagoon	11 Fuel storage	15 Oil well/Gas well
3 Watertight sewer lines	6 Seepage pit	9 Feedyard	12 Fertilizer storage	16 Other (specify below)
			13 Insecticide storage	None known

Direction from well?		LITHOLOGIC LOG	How many feet?		PLUGGING INTERVALS
FROM	TO		FROM	TO	
0	3	Topsoil			
3	25	Clay, brown			
25	30	Sand and gravel, fine, medium, loose, slightly silty			
30	35	Clay, brown, hard			
35	59	Sand and gravel, fine, medium, loose, clean			
59	65	Shale, black, hard			

7 CONTRACTOR'S OR LANDOWNER'S CERTIFICATION: This water well was (1) constructed, (2) reconstructed, or (3) plugged under my jurisdiction and was completed on (mo/day/year) 10-28-92 and this record is true to the best of my knowledge and belief. Kansas Water Well Contractor's License No. . . . 185 This Water Well Record was completed on (mo/day/yr) 11-18-92 under the business name of Clarke Well & Equipment, Inc. by (signature) *Clarke Well & Equipment*

INSTRUCTIONS: Use typewriter or ball point pen. PLEASE PRESS FIRMLY and PRINT clearly. Please fill in blanks, underline or circle the correct answers. Send top three copies to Kansas Department of Health and Environment, Bureau of Water, Topeka, Kansas 66620-0001. Telephone: 913-296-5545. Send one to WATER WELL OWNER and retain one for your records.