


1 LOCATION OF WATER WELL: Fraction  $\frac{1}{4}$  NE  $\frac{1}{4}$  W Section Number 28 Township Number T 13 S Range Number R 18W EW  
 County: Ellis  
 Distance and direction from nearest town or city street address of well if located within city?

2923 HILLCREST IN HAYS

2 WATER WELL OWNER: LEE OIKERS  
 RR#, St. Address, Box #: 2923 HILLCREST  
 City, State, ZIP Code: HAYS KS 67601  
 Board of Agriculture, Division of Water Resources  
 Application Number:

3 LOCATE WELL'S LOCATION WITH AN "X" IN SECTION BOX:

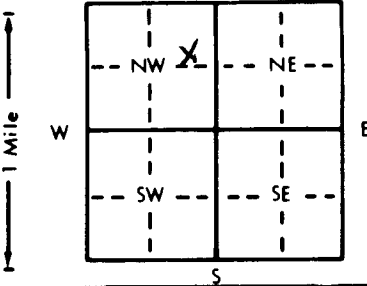

4 DEPTH OF COMPLETED WELL: 68' ft. ELEVATION:  
 Depth(s) Groundwater Encountered 1. 37' ft. 2. ft. 3. ft.  
 WELL'S STATIC WATER LEVEL: 35' ft. below land surface measured on mo/day/yr  
 Pump test data: Well water was ft. after hours pumping gpm  
 Est. Yield 20 gpm Well water was ft. after hours pumping gpm  
 Bore Hole Diameter: 10 in. to 68' ft., and in. to ft.  
 WELL WATER TO BE USED AS:  
 1 Domestic 3 Feedlot 6 Oil field water supply 9 Dewatering 12 Other (Specify below)  
 2 Irrigation 4 Industrial 7 Lawn and garden only 10 Monitoring well  
 Was a chemical/bacteriological sample submitted to Department? Yes No; If yes, mo/day/yr sample was submitted  
 Water Well Disinfected? Yes  No

5 TYPE OF BLANK CASING USED:  
 1 Steel 3 RMP (SR) 5 Wrought iron 8 Concrete tile CASING JOINTS: Glued  Clamped  
 2 PVC 4 ABS 6 Asbestos-Cement 9 Other (specify below) Welded  
 7 Fiberglass Threaded  
 Blank casing diameter 5 in. to 68' ft., Dia. in. to ft., Dia. in. to ft.  
 Casing height above land surface: 14" in., weight lbs./ft. Wall thickness or gauge No. SDR 26  
 TYPE OF SCREEN OR PERFORATION MATERIAL:  
 1 Steel 3 Stainless steel 5 Fiberglass 7 PVC 10 Asbestos-cement  
 2 Brass 4 Galvanized steel 6 Concrete tile 8 RMP (SR) 11 Other (specify)  
 12 None used (open hole)  
 SCREEN OR PERFORATION OPENINGS ARE:  
 5 Gauzed wrapped 8 Saw cut 11 None (open hole)  
 1 Continuous slot 3 Mill slot 6 Wire wrapped 9 Drilled holes  
 2 Louvered shutter 4 Key punched 7 Torch cut 10 Other (specify)  
 SCREEN-PERFORATED INTERVALS: From 68' ft. to 48' ft., From ft. to ft.  
 GRAVEL PACK INTERVALS: From 68' ft. to 45' ft., From ft. to ft.

6 GROUT MATERIAL: 1 Neat cement 2 Cement grout 3 Bentonite 4 Other  
 Grout Intervals: From 45' ft. to 22' ft., From ft. to ft., From ft. to ft.  
 What is the nearest source of possible contamination:  
 1 Septic tank 4 Lateral lines 7 Pit privy 10 Livestock pens 14 Abandoned water well  
 2 Sewer lines 5 Cess pool 8 Sewage lagoon 11 Fuel storage 15 Oil well/Gas well  
 3 Watertight sewer lines 6 Seepage pit 9 Feedyard 12 Fertilizer storage 16 Other (specify below)  
 13 Insecticide storage  
 Direction from well? S How many feet? 45'

DIRECTION FROM WELL?		LITHOLOGIC LOG	PLUGGING INTERVALS	
FROM	TO		FROM	TO
6	3	TOP SOIL		
3	7	LIMESTONE CLAY		
7	21	LIGHT BROWN CLAY		
21	27	LIGHT BROWN CLAY w/SH		
27	30	MED WHITE ROCK		
30	36	GRAY CLAY		
36	40	FINE SAND		
40	48	BROWN CLAY		
48	50	HARD WHITE ROCK		
50	65	Lg. CLEAN GRAVEL		
65	68	BLUE SHALE		

7 CONTRACTOR'S OR LANDOWNER'S CERTIFICATION: This water well was (1) constructed, (2) reconstructed, or (3) plugged under my jurisdiction and was completed on (mo/day/year) 9/19/90 and this record is true to the best of my knowledge and belief. Kansas Water Well Contractor's License No. 478 This Water Well Record was completed on (mo/day/yr) 9/19/90 under the business name of Domestical Water Well by (signature) [Signature]

OFFICE USE ONLY  
T  
R  
EW  
SEC.  
1/4  
1/4  
1/4