


1 LOCATION OF WATER WELL: County: Ellis Fraction: SE 1/4 NE 1/4 SE 1/4 Section Number: 29 Township Number: T 13 S Range Number: R 18 E (N)

Distance and direction from nearest town or city street address of well if located within city?
3110 TAMO SHANTER DR. HAYS KS

2 WATER WELL OWNER: Devin Elmer
 RR#, St. Address, Box #: 3110 TAMO SHANTER DR. Board of Agriculture, Division of Water Resources
 City, State, ZIP Code: HAYS KS 67601 Application Number:

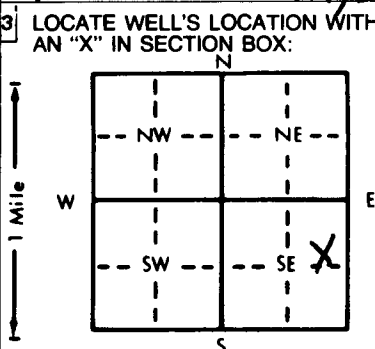

4 DEPTH OF COMPLETED WELL: 87 ft. ELEVATION:
 Depth(s) Groundwater Encountered: 1 57 ft. 2. ft. 3. ft.
 WELL'S STATIC WATER LEVEL: 59 ft. below land surface measured on 9-11-91
 Pump test data: Well water was 24 ft. after 1.5 hours pumping 20 gpm
 Est. Yield 20 gpm: Well water was ft. after hours pumping gpm
 Bore Hole Diameter: 1.0 in. to ft., and in. to ft.
 WELL WATER TO BE USED AS:
 Domestic 3 Feedlot 6 Oil field water supply 9 Dewatering 12 Other (Specify below)
 Irrigation 4 Industrial 7 Lawn and garden only 10 Monitoring well
 Was a chemical/bacteriological sample submitted to Department? Yes No If yes, mo/day/yr sample was submitted
 Water Well Disinfected? Yes No

5 TYPE OF BLANK CASING USED:
 1 Steel 3 RMP (SR) 5 Wrought iron 8 Concrete tile CASING JOINTS: Glued Clamped
 PVC 4 ABS 7 Fiberglass Threaded
 Blank casing diameter: 5 in. to ft., Dia. in. to ft., Dia. in. to ft.
 Casing height above land surface: 18 in., weight lbs./ft. Wall thickness or gauge No. SDR-21

TYPE OF SCREEN OR PERFORATION MATERIAL:
 1 Steel 3 Stainless steel 5 Fiberglass PVC 10 Asbestos-cement
 2 Brass 4 Galvanized steel 6 Concrete tile 8 RMP (SR) 11 Other (specify)
 12 None used (open hole)

SCREEN OR PERFORATION OPENINGS ARE:
 1 Continuous slot Mill slot 5 Gauzed wrapped 8 Saw cut 11 None (open hole)
 2 Louvered shutter 4 Key punched 6 Wire wrapped 9 Drilled holes
 7 Torch cut 10 Other (specify)

SCREEN-PERFORATED INTERVALS: From: 67 ft. to 87 ft., From ft. to ft.
 From ft. to ft., From ft. to ft.
 GRAVEL PACK INTERVALS: From: 50 ft. to 87 ft., From ft. to ft.
 From ft. to ft., From ft. to ft.

6 GROUT MATERIAL: 1 Neat cement Cement grout 3 Bentonite 4 Other
 Grout Intervals: From: 4 ft. to 24 ft., From ft. to ft., From ft. to ft.
 What is the nearest source of possible contamination:
 1 Septic tank 4 Lateral lines 7 Pit privy 11 Fuel storage 14 Abandoned water well
 2 Sewer lines 5 Cess pool 8 Sewage lagoon 12 Fertilizer storage 15 Oil well/Gas well
 Watertight sewer lines 6 Seepage pit 9 Feedyard 13 Insecticide storage 16 Other (specify below)
 Direction from well? North How many feet? 20 10

FROM	TO	LITHOLOGIC LOG	FROM	TO	PLUGGING INTERVALS
0	10	Top soil			
10	54	Brown clay			
54	57	blue clay			
57	80	med to fine grey sand			
80	87	shale			

7 CONTRACTOR'S OR LANDOWNER'S CERTIFICATION: This water well was constructed, (2) reconstructed, or (3) plugged under my jurisdiction and was completed on (mo/day/year) 9-11-91 and this record is true to the best of my knowledge and belief. 