


1] LOCATION OF WATER WELL: County: Ellis Fraction: SW 1/4 NE 1/4 SE 1/4 Section Number: 29 Township Number: T 13 S Range Number: R 18 EW

Distance and direction from nearest town or city street address of well if located within city?
1104 & 1106 W 36th Hays KS.

2] WATER WELL OWNER: Schumont II
 RR#, St. Address, Box #: 1104-A & B 1106-A & B W 36th St
 City, State, ZIP Code: Hays KS 67601
 Board of Agriculture, Division of Water Resources
 Application Number:

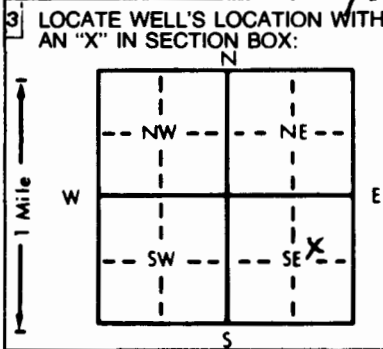

4] DEPTH OF COMPLETED WELL: 82 ft. ELEVATION:
 Depth(s) Groundwater Encountered 1. 73 ft. 2. ft. 3. ft.
 WELL'S STATIC WATER LEVEL 74 ft. below land surface measured on 4-20-92
 Pump test data: Well water was 1.5 ft. after 1.75 hours pumping 5 gpm
 Est. Yield 5 gpm Well water was ft. after hours pumping gpm
 Bore Hole Diameter: 1.0 in. to ft., and in. to ft.
 WELL WATER TO BE USED AS:
 5 Public water supply 8 Air conditioning 11 Injection well
 1 Domestic 3 Feedlot 6 Oil field water supply 9 Dewatering 12 Other (Specify below)
 2 Irrigation 4 Industrial 7 Lawn and garden only 10 Monitoring well
 Was a chemical/bacteriological sample submitted to Department? Yes.....No.....; If yes, mo/day/yr sample was submitted
 Water Well Disinfected? Yes No

5] TYPE OF BLANK CASING USED:
 1 Steel 3 RMP (SR) 5 Wrought iron 8 Concrete tile CASING JOINTS: 5 Glued Clamped
2 PVC 4 ABS 6 Asbestos-Cement 9 Other (specify below) Welded
 7 Fiberglass Threaded
 Blank casing diameter 5 in. to ft., Dia in. to ft., Dia in. to ft.
 Casing height above land surface 18 in., weight lbs./ft. Wall thickness or gauge No. SDR-26
 TYPE OF SCREEN OR PERFORATION MATERIAL:
 1 Steel 3 Stainless steel 5 Fiberglass 7 PVC 10 Asbestos-cement
 2 Brass 4 Galvanized steel 6 Concrete tile 8 RMP (SR) 11 Other (specify)
 12 None used (open hole)
 SCREEN OR PERFORATION OPENINGS ARE:
 1 Continuous slot 5 Gauzed wrapped 8 Saw cut 11 None (open hole)
 2 Louvered shutter 3 Mill slot 6 Wire wrapped 9 Drilled holes
 4 Key punched 7 Torch cut 10 Other (specify)
 SCREEN-PERFORATED INTERVALS: From 62 ft. to 82 ft., From ft. to ft.
 From ft. to ft., From ft. to ft.
 GRAVEL PACK INTERVALS: From 50 ft. to 82 ft., From ft. to ft.
 From ft. to ft., From ft. to ft.

6] GROUT MATERIAL: 1 Neat cement 2 Cement grout 3 Bentonite 4 Other
 Grout intervals: From 1 ft. to 21 ft., From ft. to ft., From ft. to ft.
 What is the nearest source of possible contamination:
 1 Septic tank 4 Lateral lines 7 Pit privy 10 Livestock pens 14 Abandoned water well
 2 Sewer lines 5 Cess pool 8 Sewage lagoon 11 Fuel storage 15 Oil well/Gas well
3 Watertight sewer lines 6 Seepage pit 9 Feedyard 12 Fertilizer storage 16 Other (specify below)
 13 Insecticide storage
 Direction from well? West How many feet? 5-20

FROM	TO	LITHOLOGIC LOG	FROM	TO	PLUGGING INTERVALS
6	15	Top soil			
15	73	brown clay			
73	80	fine grey sand mixed with layers grey clay			
80	82	Shale			

7] CONTRACTOR'S OR LANDOWNER'S CERTIFICATION: This water well was (1) constructed, (2) reconstructed, or (3) plugged under my jurisdiction and was completed on (mo/day/year) 4-20-92 and this record is true to the best of my knowledge and belief. 

INSTRUCTIONS: Use typewriter or ball point pen. PLEASE PRESS FIRMLY and PRINT clearly. Please fill in blanks, underline or circle the correct answers. Send top three copies to Kansas Department of Health and Environment, Bureau of Water, Topeka, Kansas 66620-0001. Telephone: 913-296-5545. Send one to WATER WELL OWNER and retain one for your records.