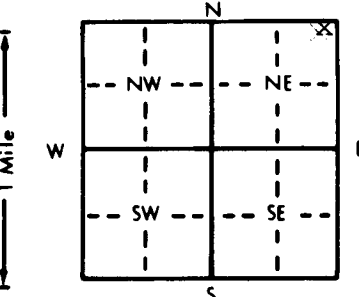


1 LOCATION OF WATER WELL: County: <u>Ellis</u>	Fraction <u>NE 1/4 NE 1/4 NE 1/4</u>	Section Number <u>29</u>	Township Number <u>T 13 S</u>	Range Number <u>R 18 E/W</u>
---	---	-----------------------------	----------------------------------	---------------------------------

Distance and direction from nearest town or city street address of well if located within city?

1555 W. 41st Hays, Kansas

2 WATER WELL OWNER: <u>John Brethour</u> RR#, St. Address, Box # : <u>1555 W. 41st</u> City, State, ZIP Code : <u>Hays, Kansas 67601</u>	Board of Agriculture, Division of Water Resources Application Number:
--	--

3 LOCATE WELL'S LOCATION WITH AN "X" IN SECTION BOX: 	4 DEPTH OF COMPLETED WELL: <u>50</u> ft. ELEVATION: <u>Upland</u> Depth(s) Groundwater Encountered 1. <u>28</u> ft. 2. _____ ft. 3. _____ ft. WELL'S STATIC WATER LEVEL: <u>30</u> ft. below land surface measured on <u>mo/day/yr</u> <u>4/26/94</u> Pump test data: Well water was <u>30</u> ft. after <u>1</u> hours pumping <u>15</u> gpm Est. Yield <u>15</u> gpm: Well water was _____ ft. after _____ hours pumping _____ gpm Bore Hole Diameter: <u>10</u> in. to <u>50</u> ft., and _____ in. to _____ ft. WELL WATER TO BE USED AS: <u>7</u> 5 Public water supply 8 Air conditioning 11 Injection well 1 Domestic 3 Feedlot 6 Oil field water supply 9 Dewatering 12 Other (Specify below) 2 Irrigation 4 Industrial <u>7 Lawn and garden only</u> 10 Monitoring well Was a chemical/bacteriological sample submitted to Department? Yes _____ No <u>X</u> ; if yes, mo/day/yr sample was submitted _____ Water Well Disinfected? Yes <u>X</u> No
--	--

5 TYPE OF BLANK CASING USED: <u>2</u> 1 Steel 3 RMP (SR) <u>2 PVC</u> 4 ABS Blank casing diameter <u>10</u> in. to <u>30</u> ft., Dia _____ in. to _____ ft., Dia _____ in. to _____ ft. Casing height above land surface <u>24</u> in., weight <u>2.29</u> lbs./ft. Wall thickness or gauge No. <u>.26</u>	5 Wrought iron 8 Concrete tile CASING JOINTS: Glued <u>X</u> Clamped _____ 6 Asbestos-Cement 9 Other (specify below) Welded _____ 7 Fiberglass _____ Threaded _____
TYPE OF SCREEN OR PERFORATION MATERIAL: <u>7</u> 1 Steel 3 Stainless steel 5 Fiberglass 8 RMP (SR) 10 Asbestos-cement 2 Brass 4 Galvanized steel 6 Concrete tile 9 ABS 11 Other (specify) _____ 12 None used (open hole)	SCREEN OR PERFORATION OPENINGS ARE: <u>8</u> 1 Continuous slot 3 Mill slot 5 Gauzed wrapped 8 Saw cut 11 None (open hole) 2 Louvered shutter 4 Key punched 6 Wire wrapped 9 Drilled holes 7 Torch cut 10 Other (specify) _____
SCREEN-PERFORATED INTERVALS: From <u>50</u> ft. to <u>30</u> ft., From _____ ft. to _____ ft. From _____ ft. to _____ ft., From _____ ft. to _____ ft.	GRAVEL PACK INTERVALS: From <u>30</u> ft. to <u>50</u> ft., From _____ ft. to _____ ft. From _____ ft. to _____ ft., From _____ ft. to _____ ft.

6 GROUT MATERIAL: <u>3</u> 1 Neat cement 2 Cement grout <u>3</u> Bentonite 4 Other _____ Grout Intervals: From <u>0</u> ft. to <u>20</u> ft., From _____ ft. to _____ ft., From _____ ft. to _____ ft.	What is the nearest source of possible contamination: <u>None</u> 1 Septic tank 4 Lateral lines 7 Pit privy 10 Livestock pens 14 Abandoned water well 2 Sewer lines 5 Cess pool 8 Sewage lagoon 11 Fuel storage 15 Oil well/Gas well 3 Watertight sewer lines 6 Seepage pit 9 Feedyard 12 Fertilizer storage 16 Other (specify below) 13 Insecticide storage <u>NONE</u>
---	--

Direction from well?			How many feet?		
FROM	TO	LITHOLOGIC LOG	FROM	TO	PLUGGING INTERVALS
0	3	Topsoil			
3	22	Gumbo			
22	28	Gumbo traces, sand			
28	35	Sand			
35	50	Shale			

7 CONTRACTOR'S OR LANDOWNER'S CERTIFICATION: This water well was (1) constructed, (2) reconstructed, or (3) plugged under my jurisdiction and was completed on (mo/day/year) <u>4/26/94</u> and this record is true to the best of my knowledge and belief. Kansas Water Well Contractor's License No. <u>199</u> This Water Well Record was completed on (mo/day/yr) <u>4/28/94</u> under the business name of <u>Karst Water Well Drilling &amp; Service, Inc.</u> by (signature) <u>[Signature]</u>
--

OFFICE USE ONLY

T

R

EW

SEC.

1/4

1/4

1/4