


1 LOCATION OF WATER WELL: County: Ellis Fraction: SE 1/4 NE 1/4 NW 1/4 Section Number: 33 Township Number: T 13 S Range Number: R 18 E/W

Distance and direction from nearest town or city street address of well if located within city?  
Un Hays

2 WATER WELL OWNER: Norman Getter  
RR#, St. Address, Box #: 310 W. 23th. Board of Agriculture, Division of Water Resources  
City, State, ZIP Code: Hays, KS 67601 Application Number:

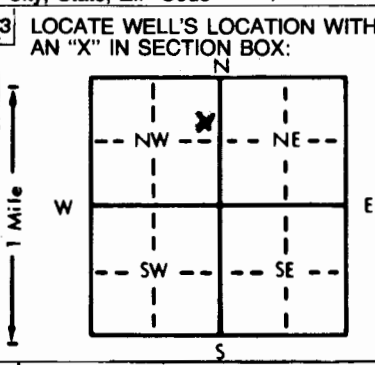

4 DEPTH OF COMPLETED WELL: 62 ft. ELEVATION: ..... ft.  
Depth(s) Groundwater Encountered 1. 41 ft. 2. .... ft. 3. .... ft.  
WELL'S STATIC WATER LEVEL: 43 ft. below land surface measured on mo/day/yr 5/24/85  
Pump test data: Well water was ..... ft. after ..... hours pumping ..... gpm  
Est. Yield 300 gpm; Well water was ..... ft. after ..... hours pumping ..... gpm  
Bore Hole Diameter: 10 1/4 in. to 62 ft., and ..... in. to ..... ft.  
WELL WATER TO BE USED AS:  
5 Public water supply 8 Air conditioning 11 Injection well  
1 Domestic 3 Feedlot 6 Oil field water supply 9 Dewatering 12 Other (Specify below)  
2 Irrigation 4 Industrial 7 Lawn and garden only 10 Observation well  
Was a chemical/bacteriological sample submitted to Department? Yes ..... No X .....; If yes, mo/day/yr sample was submitted  
Water Well Disinfected? Yes ..... No X .....

5 TYPE OF BLANK CASING USED:  
1 Steel 2 PVC 3 RMP (SR) 4 ABS  
5 Wrought iron 6 Asbestos-Cement 7 Fiberglass  
8 Concrete tile 9 Other (specify below)  
Blank casing diameter 5.56 in. to 42 ft., Dia ..... in. to ..... ft., Dia ..... in. to ..... ft.  
Casing height above land surface: 12 inches in., weight ..... lbs./ft. Wall thickness or gauge No. SDR-26  
TYPE OF SCREEN OR PERFORATION MATERIAL:  
1 Steel 2 Brass 3 Stainless steel 4 Galvanized steel 5 Fiberglass 6 Concrete tile 7 PVC 8 RMP (SR) 9 ABS 10 Asbestos-cement 11 Other (specify) ..... 12 None used (open hole)  
SCREEN OR PERFORATION OPENINGS ARE:  
1 Continuous slot 2 Louvered shutter 3 Mill slot 4 Key punched 5 Gauzed wrapped 6 Wire wrapped 7 Torch cut 8 Saw cut 9 Drilled holes 11 None (open hole) 10 Other (specify) .....  
SCREEN-PERFORATED INTERVALS: From 62 ft. to 42 ft., From ..... ft. to ..... ft.  
GRAVEL PACK INTERVALS: From 62 ft. to 30 ft., From ..... ft. to ..... ft.

6 GROUT MATERIAL: 1 Neat cement 2 Cement grout 3 Bentonite 4 Other .....  
Grout Intervals: From 10 ft. to 0 ft., From ..... ft. to ..... ft., From ..... ft. to ..... ft.  
What is the nearest source of possible contamination:  
1 Septic tank 2 Sewer lines 3 Watertight sewer lines 4 Lateral lines 5 Cess pool 6 Seepage pit 7 Pit privy 8 Sewage lagoon 9 Feedyard 10 Livestock pens 11 Fuel storage 12 Fertilizer storage 13 Insecticide storage 14 Abandoned water well 15 Oil well/Gas well 16 Other (specify below)  
Direction from well? South How many feet? 110 ft

FROM	TO	LITHOLOGIC LOG	FROM	TO	LITHOLOGIC LOG
0	4	Top soil			
4	23	Yellow clay			
23	36	Dark grey clay w/ limestone pebbles			
36	41	fine sand mixed w/clay			
41	58	medium to coarse sand & gravel			
58	62	shale			

7 CONTRACTOR'S OR LANDOWNER'S CERTIFICATION: This water well was (1) constructed, (2) reconstructed, or (3) plugged under my jurisdiction and was completed on (mo/day/year) 5/24/85 and this record is true to the best of my knowledge and belief. Kansas Water Well Contractor's License No. 455 This Water Well Record was completed on (mo/day/yr) 4/10/85 under the business name of Kraus Pump & Supply by (signature) James Becker

INSTRUCTIONS: Use typewriter or ball point pen, PLEASE PRESS FIRMLY and PRINT clearly. Please fill in blank, underline or circle the correct answers. Send top three copies to Kansas Department of Health and Environment, Division of Environment, Environmental Geology Section, Topeka, KS 66620. Send one to WATER WELL