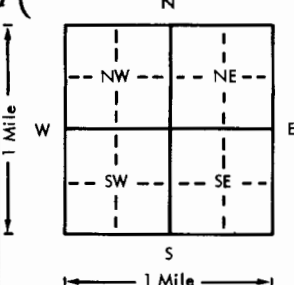
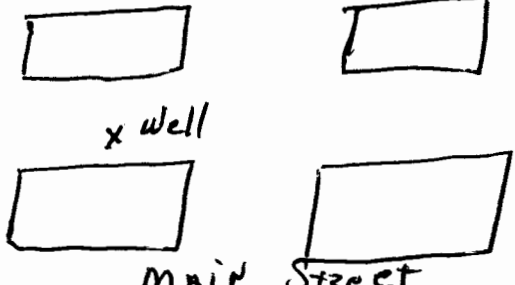


USE TYPEWRITER OR BALL POINT PEN-PRESS FIRMLY, PRINT CLEARLY.

WATER WELL RECORD
KSA 82a-1201-1215

Kansas Department of Health and Environment-Division of Environment
(Water well Contractors)
Topeka, Kansas 66620

1. Location of well: County Ellis		Fraction N/2 of NE/4 1/4 1/4 1/4			Section number 33	Township number T 13	Range number R 18 - W E/W
2. Distance and direction from nearest town or city: Street address of well location if in city: 2408 Main					3. Owner of well: LARRY BICKER R.R. or street: 107 W 13th City, state, zip code: Hays, Kansas 67601		
X. Locate with "X" in section below: 		Sketch map: 			6. Bore hole dia. 8 in. Completion date 8-20-77 Well depth 80 ft.		
5. Type and color of material					From	To	7. <input checked="" type="checkbox"/> Cable tool <input checked="" type="checkbox"/> Rotary <input type="checkbox"/> Driven <input type="checkbox"/> Dug <input type="checkbox"/> Hollow rod <input type="checkbox"/> Jetted <input type="checkbox"/> Bored <input type="checkbox"/> Reverse rotary
Alluvial					0	3	8. Use: <input type="checkbox"/> Domestic <input type="checkbox"/> Public supply <input type="checkbox"/> Industry <input type="checkbox"/> Irrigation <input type="checkbox"/> Air conditioning <input type="checkbox"/> Stock <input checked="" type="checkbox"/> Lawn <input type="checkbox"/> Oil field water <input type="checkbox"/> Other
Hard Brown Clay					3	26	9. Casing: Material <input type="checkbox"/> Threaded <input type="checkbox"/> Welded <input type="checkbox"/> Surface 12 in. RMP PVC Weight <input type="checkbox"/> lbs./ft.
" " " & White Clay					26	58	Dia. 3 in. to 80 ft. depth Wall Thickness: inches or Dia. <input type="checkbox"/> in. to <input type="checkbox"/> ft. depth gage No. 258
& Fine sand							10. Screen: Manufacturer's name MODE RN Plastics Type PVC Dia. 5 Slat gauge <input type="checkbox"/> Length 20 Set between 59 ft. and 79 ft. ft. and <input type="checkbox"/> ft.
Red & Crystal water gravel					58	79	Gravel pack? <input checked="" type="checkbox"/> Yes Size range of material Medium
Shale					79	80	11. Static water level: 40 ft. below land surface Date 8-20-77 mo./day/yr.
							12. Pumping level below land surfaces: 56 ft. after 1 hrs. pumping 23 g.p.m. ft. after <input type="checkbox"/> hrs. pumping <input type="checkbox"/> g.p.m. Estimated maximum yield 30 g.p.m.
							13. Water sample submitted: <input type="checkbox"/> Yes <input checked="" type="checkbox"/> No Date <input type="checkbox"/>
							14. Well head completion: <input type="checkbox"/> Pitless adapter 18" Inches above grade
							15. Well grouted? Yes With: <input checked="" type="checkbox"/> Neat cement <input type="checkbox"/> Bentonite <input type="checkbox"/> Concrete Depth: From 0 ft. to 10 ft.
							16. Nearest source of possible contamination: ft. 50 Direction South Type SEWER Well disinfected upon completion? <input checked="" type="checkbox"/> Yes <input type="checkbox"/> No
							17. Pump: <input type="checkbox"/> Not installed Manufacturer's name Dempster Model number 1508 HP 1/2 Volts 230 Length of drop pipe 65 ft. capacity 10 g.p.m. Type: <input checked="" type="checkbox"/> Submersible <input type="checkbox"/> Turbine <input type="checkbox"/> Jet <input type="checkbox"/> Reciprocating <input type="checkbox"/> Centrifugal <input type="checkbox"/> Other
(Use a second sheet if needed)							
18. Elevation: Topography: <input type="checkbox"/> Hill <input checked="" type="checkbox"/> Slope <input checked="" type="checkbox"/> Upland <input type="checkbox"/> Valley		19. Remarks: Sewer of water tile construction Well & Pump finished with equip. on 10-4-77			20. Water well contractor's certification: This well was drilled under my jurisdiction and this report is true to the best of my knowledge and belief. Water Well Sales 2808 Business name East 8th License No. <input type="checkbox"/> Address Terry Gordon Date 8-20-77 Signed Terry Gordon Authorized representative		

T 13 R 18 W 33 Sec N/2 of NE/4 1/4 1/4