


USE TYPEWRITER OR BALL POINT PEN-PRESS FIRMLY, PRINT CLEARLY.

WATER WELL RECORD
KSA 82a-1201-1215

Kansas Department of Health and Environment-Division of Environment
(Water well Contractors)
Topeka, Kansas 66620

1. Location of well: County Ellis Fraction NE 1/4 SW 1/4 Section number 33 Township number T 13 Range number R 18 EW

2. Distance and direction from nearest town or city: Street address of well location if in city: 305 E. 13th
3. Owner of well: Richard Stang
R.R. or street: 305 E 13th
City, state, zip code: Hays, Kansas 67601

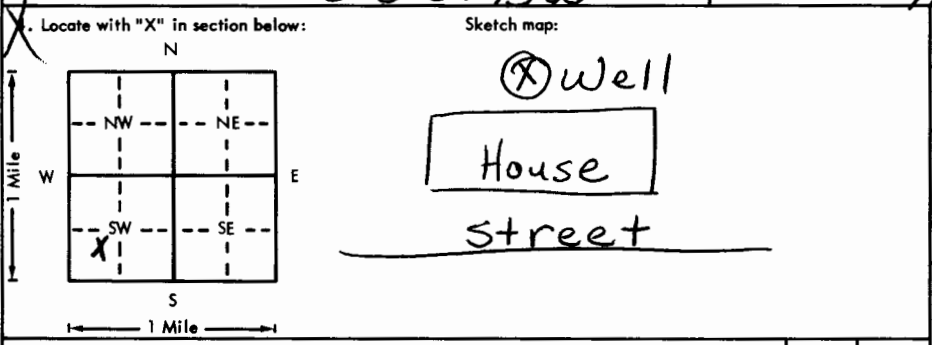

6. Bore hole dia. 9 in. Completion date 3/1/76
Well depth 50 ft.

7. Cable tool Rotary Driven Dug
 Hollow rod Jetted Bored Reverse rotary

8. Use: Domestic Public supply Industry
 Irrigation Air conditioning Stock
 Lawn Oil field water Other

Casing: Material PVC Height: Above or below
Threaded Welded Surface 15 in.
RMP PVC Weight lbs./ft.
Dia. 5 in. to 50 ft. depth Wall Thickness: inches or
Dia. in. to ft. depth gage No. 258

5. Type and color of material	From	To
Topsoil	0	5
Subsoil	5	12
Brown Clay	12	25
Medium Sand	25	37
Yellow Clay	37	40
Gravel	40	47
Blue Shale	47	50
(Use a second sheet if needed)		

10. Screen: Manufacturer's name Jet Stream
Type PVC Dia. 3"
 Slot gauge Length 10'
Set between 38 ft. and 48 ft.
ft. and ft.
Gravel pack? Yes Size range of material 1/4"

11. Static water level: 30 ft. below land surface Date 3/1/76 mo./day/yr.
12. Pumping level below land surfaces:
35 ft. after 1 hrs. pumping 10 g.p.m.
 ft. after hrs. pumping g.p.m.
Estimated maximum yield 10 g.p.m.

13. Water sample submitted: mo./day/yr.
Yes No Date

14. Well head completion:
 Pitless adapter 15 inches above grade
 Well grouted? Yes
With: Neat cement Bentonite Concrete
Depth: From 1 ft. to 10 ft.

16. Nearest source of possible contamination: None
ft. Direction Type
Well disinfected upon completion? Yes No

17. Pump: Not installed
Manufacturer's name Eqw
Model number 5BA8 HP 1/2 Volts 220
Length of drop pipe 45 ft. capacity 10 g.p.m.
Type:
 Submersible Turbine
 Jet Reciprocating
 Centrifugal Other

18. Elevation:
Topography:
 Hill
 Slope
 Upland
 Valley

19. Remarks:
None



Water well contractor's certification:
This well was drilled under my jurisdiction and this report is true to the best of my knowledge and belief.
Karst Water Well 199A
Business name License No.
Address E. Hwy 40 Hays
Signed Date 3/1/76
Authorized representative