


1 LOCATION OF WATER WELL: Fraction SW 1/4 NE 1/4 SE 1/4 Section Number 33 Township Number T 13 S Range Number R 18 E/W
 County: Ellis
 Distance and direction from nearest town or city street address of well if located within city?
In Hays

2 WATER WELL OWNER: Harold Beer
 RR#, St. Address, Box #: 500 East 18th
 City, State, ZIP Code: Hays, KS 67601
 Board of Agriculture, Division of Water Resources
 Application Number:

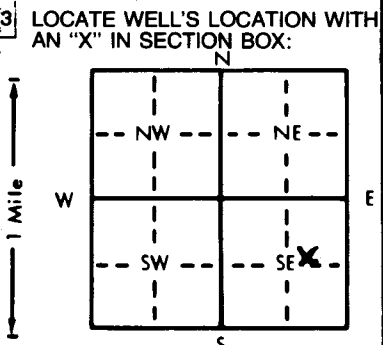

4 DEPTH OF COMPLETED WELL: 77 ft ft. ELEVATION:
 Depth(s) Groundwater Encountered 1. 69 ft ft. 2. 49 ft ft. 3. 159 pm ft.
 WELL'S STATIC WATER LEVEL 49 ft ft. below land surface measured on mo/day/yr 5/30/84
 Pump test data: Well water was 52 ft ft. after 3 hrs hours pumping 159 pm gpm
 Est. Yield 20 gpm gpm: Well water was 52 ft ft. after 3 hrs hours pumping 159 pm gpm
 Bore Hole Diameter: 10 1/4 in. to 7 7/8 ft., and 7 7/8 in. to 7 7/8 ft.
 WELL WATER TO BE USED AS:
 1 Domestic 3 Feedlot 6 Oil field water supply 9 Dewatering 12 Other (Specify below)
 2 Irrigation 4 Industrial 7 Lawn and garden only 10 Observation well
 Was a chemical/bacteriological sample submitted to Department? Yes X No X; If yes, mo/day/yr sample was submitted
 Water Well Disinfected? Yes X No O

5 TYPE OF BLANK CASING USED:
 1 Steel 3 RMP (SR) 5 Wrought iron 8 Concrete tile CASING JOINTS: Glued X Clamped
2 PVC 4 ABS 7 Fiberglass 9 Other (specify below) Welded
 Threaded
 Blank casing diameter 5.56 in. to 4 7/8 ft. Dia. 12 inches in. to 4 7/8 ft. Dia. SDR 26 lbs./ft. Wall thickness or gauge No.
 TYPE OF SCREEN OR PERFORATION MATERIAL:
 1 Steel 3 Stainless steel 5 Fiberglass 8 RMP (SR) 10 Asbestos-cement 11 Other (specify)
 2 Brass 4 Galvanized steel 6 Concrete tile 9 ABS 12 None used (open hole)
 SCREEN OR PERFORATION OPENINGS ARE:
 1 Continuous slot 3 Mill slot 5 Gauzed wrapped 8 Saw cut 11 None (open hole)
 2 Louvered shutter 4 Key punched 6 Wire wrapped 9 Drilled holes
 7 Torch cut 10 Other (specify)
 SCREEN-PERFORATED INTERVALS: From 77 ft ft. to 47 ft ft., From 77 ft ft. to 47 ft ft., From 77 ft ft. to 47 ft ft., From 77 ft ft. to 47 ft ft.
 GRAVEL PACK INTERVALS: From 77 ft ft. to 40 ft ft., From 77 ft ft. to 40 ft ft., From 77 ft ft. to 40 ft ft., From 77 ft ft. to 40 ft ft.

6 GROUT MATERIAL: 1 Neat cement 2 Cement grout 3 Bentonite 4 Other
 Grout Intervals: From 10 ft. to 0 ft., From 10 ft. to 0 ft., From 10 ft. to 0 ft., From 10 ft. to 0 ft.
 What is the nearest source of possible contamination:
 1 Septic tank 4 Lateral lines 7 Pit privy 11 Fuel storage 14 Abandoned water well
2 Sewer lines 5 Cess pool 8 Sewage lagoon 12 Fertilizer storage 15 Oil well/Gas well
 3 Watertight sewer lines 6 Seepage pit 9 Feedyard 13 Insecticide storage 16 Other (specify below)
 Direction from well? West How many feet? 50 feet

FROM	TO	LITHOLOGIC LOG	FROM	TO	LITHOLOGIC LOG
0	7	Top soil			
7	38	Clay			
38	40	fine sand			
40	51	fine sand & clay			
51	59	Blue clay w/ limestone and sand			
59	74	fine to medium gravel			
74	77	shale			

7 CONTRACTOR'S OR LANDOWNER'S CERTIFICATION: This water well was (1) constructed (2) reconstructed, or (3) plugged under my jurisdiction and was completed on (mo/day/year) 5/29/84 and this record is true to the best of my knowledge and belief. Kansas Water Well Contractor's License No. 455 This Water Well Record was completed on (mo/day/yr) 6/4/84 under the business name of Trans Pump Supply by (signature) James Bieker

INSTRUCTIONS: Use typewriter or ball point pen, PLEASE PRESS FIRMLY and PRINT clearly. Please fill in blanks, underline or circle the correct answers. Send top

OFFICE USE ONLY
T
R
SEC.
SW 1/4 NE 1/4 SE 1/4