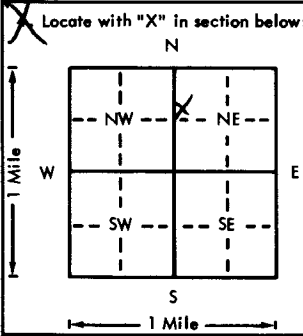
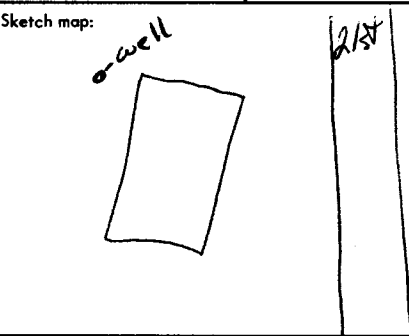


1223

USE TYPEWRITER OR BALL POINT PEN-PRESS FIRMLY, PRINT CLEARLY.

WATER WELL RECORD  
KSA 82a-1201-1215

Kansas Department of Health and Environment-Division of Environment  
(Water well Contractors)  
Topeka, Kansas 66620

1. Location of well:	County: <u>ELLIS</u>	Fraction: <u>SW 1/4 NW 1/4 NE 1/4</u>	Section number: <u>33</u>	Township number: <u>T 13 S</u>	Range number: <u>R 18 E</u>
2. Distance and direction from nearest town or city: Street address of well location if in city: <u>404 W. 21st</u>			3. Owner of well: <u>Dave Rudder</u> R.R. or street: <u>404 W. 21st</u> City, state, zip code: <u>Hays, Kansas</u>		
X Locate with "X" in section below: 		Sketch map: 		6. Bore hole dia. <u>9</u> in. Completion date <u>8/24/77</u> Well depth <u>70</u> ft.	
5. Type and color of material		From	To	7. <input type="checkbox"/> Cable tool <input checked="" type="checkbox"/> Rotary <input type="checkbox"/> Driven <input type="checkbox"/> Dug <input type="checkbox"/> Hollow rod <input type="checkbox"/> Jetted <input type="checkbox"/> Bored <input type="checkbox"/> Reverse rotary	
<u>Topsail</u>		<u>0</u>	<u>4</u>	8. Use: <input type="checkbox"/> Domestic <input type="checkbox"/> Public supply <input type="checkbox"/> Industry <input type="checkbox"/> Irrigation <input type="checkbox"/> Air conditioning <input type="checkbox"/> Stock <input checked="" type="checkbox"/> Lawn <input type="checkbox"/> Oil field water <input type="checkbox"/> Other	
<u>Yellow clay</u>		<u>4</u>	<u>38</u>	X Casing: Material <u>PVC</u> Height: <u>Above</u> or below Threaded <input type="checkbox"/> Welded <input checked="" type="checkbox"/> Surface <u>7/8</u> in. RMP <input type="checkbox"/> PVC <input checked="" type="checkbox"/> Weight <u>160</u> lbs./ft. Dia. <u>5</u> in. to <u>70</u> ft. depth <input checked="" type="checkbox"/> All Thickness: inches or Dia. <u>   </u> in. to <u>   </u> ft. depth gage No. <u>258</u>	
<u>Brown clay with some fine sand</u>		<u>38</u>	<u>52</u>	X Screen: Manufacturer's name <u>Jet stream</u> <u>PVC</u> Type <u>PVC</u> Dia. <u>5"</u> Gauze <u>.031</u> Length <u>10</u> Set between <u>40</u> ft. and <u>70</u> ft. Gravel pack? <u>yes</u> Size range of material <u>1/4 - 1/8</u>	
<u>Medium to fine sand</u>		<u>52</u>	<u>67</u>	11. Static water level: <u>35</u> ft. below land surface Date <u>8/24/77</u>	
<u>Blue shale</u>		<u>67</u>	<u>70</u>	12. Pumping level below land surfaces: <u>35</u> ft. after <u>1</u> hrs. pumping <u>10</u> g.p.m. <u>   </u> ft. after <u>   </u> hrs. pumping <u>   </u> g.p.m. Estimated maximum yield <u>10</u> g.p.m.	
				13. Water sample submitted: <u>   </u> mo./day/yr. Yes <input type="checkbox"/> No <input checked="" type="checkbox"/> Date <u>   </u>	
				14. Well head completion: <input type="checkbox"/> Pitless adapter <u>16</u> Inches above grade	
				X Well grouted? <u>yes</u> With: <input type="checkbox"/> Neat cement <input type="checkbox"/> Bentonite <input checked="" type="checkbox"/> Concrete Depth: From <u>2</u> ft. to <u>10</u> ft.	
				16. Nearest source of possible contamination: <u>none</u> ft. <u>   </u> Direction <u>   </u> Type <u>   </u> Well disinfected upon completion? <input checked="" type="checkbox"/> Yes <input type="checkbox"/> No	
				17. Pump: <u>   </u> Not installed Manufacturer's name <u>FGW</u> Model number <u>5BAX</u> HP <u>1/2</u> Volts <u>230</u> Length of drop pipe <u>65</u> ft. capacity <u>10</u> g.p.m. Type: <input checked="" type="checkbox"/> Submersible <input type="checkbox"/> Turbine <input type="checkbox"/> Jet <input type="checkbox"/> Reciprocating <input type="checkbox"/> Centrifugal <input type="checkbox"/> Other	
				20. Water well contractor's certification: This well was drilled under my jurisdiction and this report is true to the best of my knowledge and belief. <u>KARST WATER WELL DRILLERS</u> Business name <u>   </u> License No. <u>   </u> Address <u>404 W. 21st</u> Signed <u>Dave Rudder</u> Date <u>8/24/77</u> Authorized representative	
18. Elevation:	19. Remarks:				
Topography: <input type="checkbox"/> Hill <input checked="" type="checkbox"/> Slope <input checked="" type="checkbox"/> Upland <input type="checkbox"/> Valley					