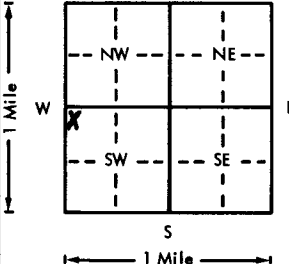
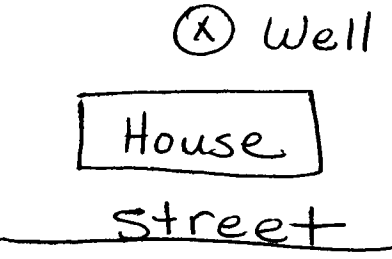


USE TYPEWRITER OR BALL POINT PEN-PRESS FIRMLY, PRINT CLEARLY.

WATER WELL RECORD  
KSA 82a-1201-1215

Kansas Department of Health and Environment-Division of Environment  
(Water well Contractors)  
Topeka, Kansas 66620

1. Location of well:	County <b>Ellis</b>	X Location <b>SW</b> NW 1/4 NW 1/4 <del>SE</del> 1/4	Section number <b>33</b>	Township number T <b>13</b> S R <b>18</b> E <b>W</b>	Range number
2. Distance and direction from nearest town or city: Street address of well location if in city: <b>306 E. 14th</b>			3. Owner of well: <b>Killian Gross</b> R.R. or street: <b>306 E 14th</b> City, state, zip code: <b>Hays, Kansas 67601</b>		
X Locate with "X" in section below: 		Sketch map: 		6. Bore hole dia. <b>7</b> in. Completion date <b>3/1/76</b> Well depth <b>50</b> ft.	
5. Type and color of material		From	To	7. Cable tool <input checked="" type="checkbox"/> Rotary <input type="checkbox"/> Driven <input type="checkbox"/> Dig <input type="checkbox"/> Hollow rod <input type="checkbox"/> Jetted <input type="checkbox"/> Bored <input type="checkbox"/> Reverse rotary	
Topsoil		0	5	8. Use: <input type="checkbox"/> Domestic <input type="checkbox"/> Public supply <input type="checkbox"/> Industry <input type="checkbox"/> Irrigation <input type="checkbox"/> Air conditioning <input type="checkbox"/> Stock <input checked="" type="checkbox"/> Lawn <input type="checkbox"/> Oil field water <input type="checkbox"/> Other	
Subsoil		5	12	X Casing: Material <b>PVC</b> Height: <b>Above</b> or below Threaded <input type="checkbox"/> Welded <input checked="" type="checkbox"/> Surface <b>15</b> in. RMP <input type="checkbox"/> PVC <input checked="" type="checkbox"/> Weight <b>2.8</b> lbs./ft. Dia. <b>5</b> in. to <b>50</b> ft. depth Wall Thickness: inches or Dio. <input type="checkbox"/> in. to <input type="checkbox"/> ft. depth gage No. <b>258</b>	
Brown Clay		12	25	10. Screen: Manufacturer's name <b>Jet Stream</b>	
Medium Sand		25	37	Type <b>PVC</b> Dia. <b>5"</b>	
Yellow Clay		37	40	Slot/gauze <b>10'</b> Length <b>10'</b>	
Gravel		40	47	Set between <b>38</b> ft. and <b>48</b> ft.	
Blue Shale		47	50	Gravel pack? <b>yes</b> Size range of material <b>1/4"</b>	
				11. Static water level: _____ mo./day/yr. <b>30</b> ft. below land surface Date <b>3/1/76</b>	
				12. Pumping level below land surfaces: <b>35</b> ft. after <b>1</b> hrs. pumping <b>10</b> g.p.m. _____ ft. after _____ hrs. pumping _____ g.p.m. Estimated maximum yield <b>10</b> g.p.m.	
				13. Water sample submitted: _____ mo./day/yr. Yes <input checked="" type="checkbox"/> No <input type="checkbox"/> Date _____	
				14. Well head completion: <input type="checkbox"/> Pitless adapter <b>15</b> inches above grade	
				X Well grouted? <b>yes</b> With: <input type="checkbox"/> Neat cement <input type="checkbox"/> Bentonite <input checked="" type="checkbox"/> Concrete Depth: From <b>1</b> ft. to <b>10</b> ft.	
				16. Nearest source of possible contamination: <b>None</b> ft. _____ Direction _____ Type _____ Well disinfected upon completion? <input checked="" type="checkbox"/> Yes <input type="checkbox"/> No	
				17. Pump: <input checked="" type="checkbox"/> Not installed Manufacturer's name _____ Model number _____ HP _____ Volts _____ Length of drop pipe _____ ft. capacity _____ g.p.m. Type: <input type="checkbox"/> Submersible <input type="checkbox"/> Turbine <input type="checkbox"/> Jet <input type="checkbox"/> Reciprocating <input type="checkbox"/> Centrifugal <input type="checkbox"/> Other	
				X 18. Water well contractor's certification: This well was drilled under my jurisdiction and this report is true to the best of my knowledge and belief. <b>Karst Water Well 199A</b> Business name _____ License No. _____ Address <b>E Hwy 40 Hays</b> Signed <b>CH B. [Signature]</b> Date <b>3/1/76</b> Authorized representative	
18. Elevation:	19. Remarks: <b>None</b>				
Topography: <input checked="" type="checkbox"/> Hill <input type="checkbox"/> Slope <input type="checkbox"/> Upland <input type="checkbox"/> Valley					