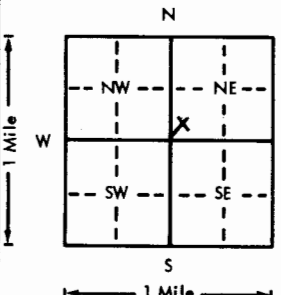
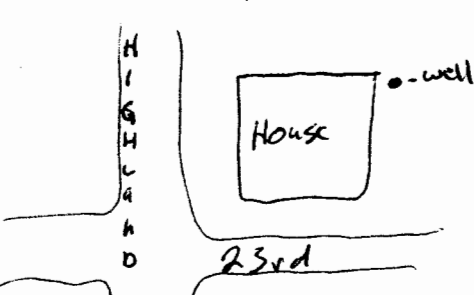


USE TYPEWRITER OR BALL POINT PEN-PRESS FIRMLY, PRINT CLEARLY.

WATER WELL RECORD
KSA 82a-1201-1215

Kansas Department of Health and Environment-Division of Environment
(Water well Contractors)
Topeka, Kansas 66620

1. Location of well: County ELLIS		Fraction SW 1/4 SW 1/4 NE 1/4		Section number 33		Township number T 13 S		Range number R 18 E	
2. Distance and direction from nearest town or city: Street address of well location if in city: SAME				3. Owner of well: Gail Palmberg R.R. or street: 116 East 23rd City, state, zip code: HAYS, KS, 67601					
4. Locate with "X" in section below: 				Sketch map: 		6. Bore hole dia. 9 in. Completion date 10-11-77 Well depth 85 ft.			
5. Type and color of material				From		To		7. <input type="checkbox"/> Cable tool <input checked="" type="checkbox"/> Rotary <input type="checkbox"/> Driven <input type="checkbox"/> Dug <input type="checkbox"/> Hollow rod <input type="checkbox"/> Jetted <input type="checkbox"/> Bored <input type="checkbox"/> Reverse rotary	
				8. Use: <input type="checkbox"/> Domestic <input type="checkbox"/> Public supply <input type="checkbox"/> Industry <input type="checkbox"/> Irrigation <input type="checkbox"/> Air conditioning <input type="checkbox"/> Stock <input checked="" type="checkbox"/> Lawn <input type="checkbox"/> Oil field water <input type="checkbox"/> Other					
Topsoil Yellow sub-soil Yellow clay Yellow clay mixed with some fine sand Medium sand Blue shale				From		To		9. Casing: Material <input type="checkbox"/> Threaded <input type="checkbox"/> Welded <input checked="" type="checkbox"/> RMP <input type="checkbox"/> PVC <input checked="" type="checkbox"/> Dia. 5 in. to 85 ft. depth Height: Above or below Surface 16 in. Weight <input type="checkbox"/> lbs./ft. Wall Thickness: inches or gage No. 160151	
				10. Screen: Manufacturer's name Jet Stream Type PVC Dia. 5" Slot/gauze Length 10' Set between 82 75 ft. and 85 ft. and <input type="checkbox"/> ft. Gravel pack? YES Size range of material 1/4-1/8					
				From		To		11. Static water level: 65 ft. below land surface Date 10-11-77	
				12. Pumping level below land surfaces: 65 ft. after 1 hrs. pumping 10 g.p.m. ____ ft. after ____ hrs. pumping ____ g.p.m. Estimated maximum yield ____ g.p.m.					
				From		To		13. Water sample submitted: <input type="checkbox"/> Yes <input checked="" type="checkbox"/> No Date ____	
				14. Well head completion: <input type="checkbox"/> Pitless adapter 116 Inches above grade					
				From		To		15. Well grouted? YES With: <input type="checkbox"/> Neat cement <input type="checkbox"/> Bentonite <input checked="" type="checkbox"/> Concrete Depth: From 0 ft. to 10 ft.	
				16. Nearest source of possible contamination: NONE ft. ____ Direction ____ Type ____ Well disinfected upon completion? <input checked="" type="checkbox"/> Yes <input type="checkbox"/> No					
				From		To		17. Pump: <input checked="" type="checkbox"/> Not installed Manufacturer's name ____ Model number ____ HP ____ Volts ____ Length of drop pipe ____ ft. capacity ____ g.p.m. Type: <input type="checkbox"/> Submersible <input type="checkbox"/> Turbine <input type="checkbox"/> Jet <input type="checkbox"/> Reciprocating <input type="checkbox"/> Centrifugal <input type="checkbox"/> Other	
				18. Elevation:		19. Remarks:		20. Water well contractor's certification: This well was drilled under my jurisdiction and this report is true to the best of my knowledge and belief. HERST WATER WELL Business name Hiway 40 Hays License No. 199A Address 149A Signed Ed B. Hart Date 10-11-77 Authorized representative	

T 13 R 18 E S 33 SW 1/4 NE 1/4