


1 LOCATION OF WATER WELL: County: **Ellis** Fraction: **NE 1/4 NW 1/4 SE 1/4** Section Number: **33** Township Number: **T 13 S** Range Number: **R 18 E**

Distance and direction from nearest town or city street address of well if located within city?
2001 Lincoln Drive, Hays, Kansas

2 WATER WELL OWNER: **Emma Eddy**
 RR#, St. Address, Box #: **2001 Lincoln Drive**
 City, State, ZIP Code: **Hays, Kansas 67601**
 Board of Agriculture, Division of Water Resources
 Application Number:

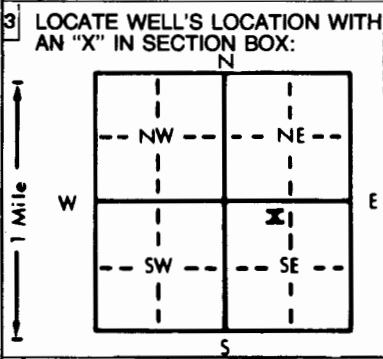

4 DEPTH OF COMPLETED WELL: **67** ft. ELEVATION: **Upland**
 Depth(s) Groundwater Encountered 1. **50** ft. 2. ft. 3. ft.
 WELL'S STATIC WATER LEVEL: **47** ft. below land surface measured on **July 10, 1985**
 Pump test data: Well water was **47** ft. after **1** hours pumping **20** gpm
 Est. Yield: **20** gpm: Well water was ft. after hours pumping gpm
 Bore Hole Diameter: **10** in. to **67** ft., and in. to ft.
 WELL WATER TO BE USED AS: **7** 5 Public water supply 8 Air conditioning 11 Injection well
 1 Domestic 3 Feedlot 6 Oil field water supply 9 Dewatering 12 Other (Specify below)
 2 Irrigation 4 Industrial **7 Lawn and garden only** 10 Observation well
 Was a chemical/bacteriological sample submitted to Department? Yes.....No **X**.....; If yes, mo/day/yr sample was submitted
 Water Well Disinfected? Yes **X** No

5 TYPE OF BLANK CASING USED: **2** 5 Wrought iron 8 Concrete tile CASING JOINTS: Glued **X** Clamped
 1 Steel 3 RMP (SR) 6 Asbestos-Cement 9 Other (specify below) Welded
 2 **PVC** 4 ABS 7 Fiberglass Threaded
 Blank casing diameter: **5** in. to **57** ft., Dia. **160** in. to ft., Dia. in. to ft.
 Casing height above land surface: **18** in., weight **160** lbs./ft. Wall thickness or gauge No. **26**
 TYPE OF SCREEN OR PERFORATION MATERIAL: **7** 7 PVC 10 Asbestos-cement
 1 Steel 3 Stainless steel 5 Fiberglass 8 RMP (SR) 11 Other (specify)
 2 Brass 4 Galvanized steel 6 Concrete tile 9 ABS 12 None used (open hole)
 SCREEN OR PERFORATION OPENINGS ARE: **8** 5 Gauzed wrapped 8 Saw cut 11 None (open hole)
 1 Continuous slot 3 Mill slot 6 Wire wrapped 9 Drilled holes
 2 Louvered shutter 4 Key punched 7 Torch cut 10 Other (specify)
 SCREEN-PERFORATED INTERVALS: From **57** ft. to **67** ft., From ft. to ft.
 From ft. to ft., From ft. to ft.
 GRAVEL PACK INTERVALS: From **37** ft. to **67** ft., From ft. to ft.
 From ft. to ft., From ft. to ft.

6 GROUT MATERIAL: **1** 1 Neat cement 2 Cement grout 3 Bentonite 4 Other
 Grout Intervals: From **4** ft. to **14** ft., From ft. to ft., From ft. to ft.
 What is the nearest source of possible contamination: **None**
 1 Septic tank 4 Lateral lines 7 Pit privy 10 Livestock pens 14 Abandoned water well
 2 Sewer lines 5 Cess pool 8 Sewage lagoon 11 Fuel storage 15 Oil well/Gas well
 3 Watertight sewer lines 6 Seepage pit 9 Feedyard 12 Fertilizer storage 16 Other (specify below)
 13 Insecticide storage
 Direction from well? How many feet?

FROM	TO	LITHOLOGIC LOG	FROM	TO	LITHOLOGIC LOG
0	2	Topsoil			
2	18	Brown clay			
18	32	Sandy clay			
32	44	Gray clay			
44	54	Blue clay			
54	64	Sand			
64	67	Shale			

7 CONTRACTOR'S OR LANDOWNER'S CERTIFICATION: This water well was **(1) constructed**, (2) reconstructed, or (3) plugged under my jurisdiction and was completed on (mo/day/year) **July 16, 1985** and this record is true to the best of my knowledge and belief. Kansas Water Well Contractor's License No. **199** This Water Well Record was completed on (mo/day/yr) **August 16, 1985** under the business name of **Karst Water Well Drlg. & Serv., Inc.** by (signature) *Neil Karst*

INSTRUCTIONS: Use typewriter or ball point pen, PLEASE PRESS FIRMLY and PRINT clearly. Please fill in blanks, underline or circle the correct answers. Send top three copies to Kansas Department of Health and Environment, Division of Environment, Environmental Geology Section, Topeka, KS 66620. Send one to WATER WELL