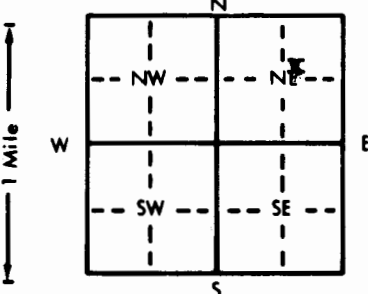


1 LOCATION OF WATER WELL: County: <u>Ellis</u>	Fraction <u>SW</u> 1/4 NE 1/4 NE 1/4	Section Number <u>33</u>	Township Number T <u>13</u> S	Range Number R <u>18</u> W
---	---	-----------------------------	----------------------------------	-------------------------------

Distance and direction from nearest town or city street address of well if located within city?

2407 Oak Hays, Kansas 67601

2 WATER WELL OWNER: <u>Marvin Wagner</u> RR#, St. Address, Box # : <u>2407 Oak</u> City, State, ZIP Code : <u>Hays, Kansas 67601</u>	Board of Agriculture, Division of Water Resources Application Number:
--	--

3 LOCATE WELL'S LOCATION WITH AN "X" IN SECTION BOX: 	4 DEPTH OF COMPLETED WELL: <u>80</u> ft. ELEVATION: <u>Upland</u> Depth(s) Groundwater Encountered 1. <u>57</u> ft. 2. _____ ft. 3. _____ ft. WELL'S STATIC WATER LEVEL <u>49</u> ft. below land surface measured on <u>mo/day/yr</u> <u>7/8/88</u> Pump test data: Well water was <u>51</u> ft. after <u>1</u> hours pumping <u>15</u> gpm Est. Yield <u>15</u> gpm: Well water was _____ ft. after _____ hours pumping _____ gpm Bore Hole Diameter <u>10</u> in. to <u>80</u> ft., and _____ in. to _____ ft. WELL WATER TO BE USED AS: <u>7</u> 5 Public water supply 8 Air conditioning 11 Injection well 1 Domestic 3 Feedlot 6 Oil field water supply 9 Dewatering 12 Other (Specify below) 2 Irrigation 4 Industrial <u>7</u> Lawn and garden only 10 Observation well Was a chemical/bacteriological sample submitted to Department? Yes _____ No <input checked="" type="checkbox"/> If yes, mo/day/yr sample was submitted _____ Water Well Disinfected? Yes <input checked="" type="checkbox"/> No
--	--

5 TYPE OF BLANK CASING USED: <u>2</u> 1 Steel 3 RMP (SR) <u>2</u> PVC 4 ABS	5 Wrought iron 8 Concrete tile 6 Asbestos-Cement 9 Other (specify below) 7 Fiberglass	CASING JOINTS: Glued <input checked="" type="checkbox"/> Clamped _____ Welded _____ Threaded _____
Blank casing diameter <u>5</u> in. to <u>60</u> ft., Dia _____ in. to _____ ft., Dia _____ in. to _____ ft. Casing height above land surface <u>16</u> in., weight <u>160</u> lbs./ft. Wall thickness or gauge No. <u>26</u>		
TYPE OF SCREEN OR PERFORATION MATERIAL: <u>7</u> 1 Steel 3 Stainless steel 5 Fiberglass <u>7</u> PVC 10 Asbestos-cement 2 Brass 4 Galvanized steel 6 Concrete tile 8 RMP (SR) 11 Other (specify) _____ 12 None used (open hole)		
SCREEN OR PERFORATION OPENINGS ARE: <u>8</u> 1 Continuous slot 3 Mill slot 5 Gauzed wrapped 8 Saw cut 11 None (open hole) 2 Louvered shutter 4 Key punched 6 Wire wrapped 9 Drilled holes 7 Torch cut 10 Other (specify) _____		
SCREEN-PERFORATED INTERVALS: From <u>60</u> ft. to <u>80</u> ft., From _____ ft. to _____ ft. From _____ ft. to _____ ft., From _____ ft. to _____ ft.		
GRAVEL PACK INTERVALS: From <u>20</u> ft. to <u>80</u> ft., From _____ ft. to _____ ft. From _____ ft. to _____ ft., From _____ ft. to _____ ft.		

6 GROUT MATERIAL: <u>1</u> 1 Neat cement 2 Cement grout 3 Bentonite 4 Other _____	Grout Intervals: From <u>0</u> ft. to <u>20</u> ft., From _____ ft. to _____ ft., From _____ ft. to _____ ft.
What is the nearest source of possible contamination: <u>None</u> 1 Septic tank 4 Lateral lines 7 Pit privy 10 Livestock pens 14 Abandoned water well 2 Sewer lines 5 Cess pool 8 Sewage lagoon 11 Fuel storage 15 Oil well/Gas well 3 Watertight sewer lines 6 Seepage pit 9 Feedyard 12 Fertilizer storage 16 Other (specify below) 13 Insecticide storage <u>None</u>	

Direction from well?		LITHOLOGIC LOG		LITHOLOGIC LOG	
FROM	TO	FROM	TO	FROM	TO
0	3				
3	30				
30	35				
35	50				
50	57				
57	77				
77	80				

7 CONTRACTOR'S OR LANDOWNER'S CERTIFICATION: This water well was (1) constructed, (2) reconstructed, or (3) plugged under my jurisdiction and was completed on (mo/day/year) 7/8/88 and this record is true to the best of my knowledge and belief. Kansas Water Well Contractor's License No. 199. This Water Well Record was completed on (mo/day/yr) 7/19/88 under the business name of Karst Water Well Drilling & Service Inc. by (signature) \_\_\_\_\_