


1 LOCATION OF WATER WELL: Fraction NE 1/4 NE 1/4 NE 1/4 Section Number 33 Township Number T 13 S Range Number R 18 E (W)  
 County: Ellis

Distance and direction from nearest town or city street address of well if located within city?  
2405 Oak St Hays Ks.

2 WATER WELL OWNER: RON WIESNER  
 RR#, St. Address, Box #: 2405 Oak St. Board of Agriculture, Division of Water Resources  
 City, State, ZIP Code: Hays Ks 62601 Application Number:

3 LOCATE WELL'S LOCATION WITH AN "X" IN SECTION BOX:

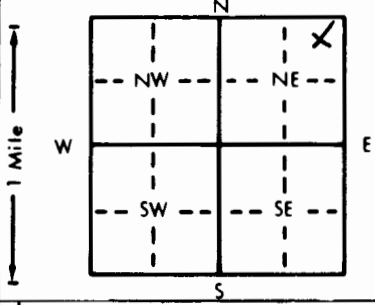

4 DEPTH OF COMPLETED WELL 74 ft. ELEVATION:

Depth(s) Groundwater Encountered 1. 52 ft. 2. . . . . ft. 3. . . . . ft.  
 WELL'S STATIC WATER LEVEL 50 ft. below land surface measured on mo/day/yr 8/23/90  
 Pump test data: Well water was 21 ft. after 1 hours pumping 20 gpm  
 Est. Yield 20 gpm: Well water was . . . . . ft. after . . . . . hours pumping . . . . . gpm  
 Bore Hole Diameter 10 in. to . . . . . ft., and . . . . . in. to . . . . . ft.  
 WELL WATER TO BE USED AS:  
 Domestic 3 Feedlot 6 Oil field water supply 9 Dewatering 12 Other (Specify below)  
 2 Irrigation 4 Industrial 7 Lawn and garden only 10 Monitoring well  
 Was a chemical/bacteriological sample submitted to Department? Yes . . . . . No ; If yes, mo/day/yr sample was submitted  
 Water Well Disinfected?  Yes No

5 TYPE OF BLANK CASING USED:  
 1 Steel  3 RMP (SR)  5 Wrought iron  8 Concrete tile  CASING JOINTS:  Glued  Clamped  
 2 PVC  4 ABS  6 Asbestos-Cement  9 Other (specify below)  Welded  
 7 Fiberglass  Threaded

Blank casing diameter 5 in. to . . . . . ft., Dia. . . . . in. to . . . . . ft., Dia. . . . . in. to . . . . . ft.  
 Casing height above land surface 20 in., weight . . . . . lbs./ft. Wall thickness or gauge No. SOR-26

TYPE OF SCREEN OR PERFORATION MATERIAL:  
 PVC  10 Asbestos-cement  
 1 Steel  3 Stainless steel  5 Fiberglass  8 RMP (SR)  11 Other (specify) . . . . .  
 2 Brass  4 Galvanized steel  6 Concrete tile  9 ABS  12 None used (open hole)

SCREEN OR PERFORATION OPENINGS ARE:  
 1 Continuous slot  3 Mill slot  5 Gauzed wrapped  8 Saw cut  11 None (open hole)  
 2 Louvered shutter  4 Key punched  6 Wire wrapped  9 Drilled holes   
 7 Torch cut  10 Other (specify) . . . . .

SCREEN-PERFORATED INTERVALS: From 54 ft. to 74 ft., From . . . . . ft. to . . . . . ft.  
 From . . . . . ft. to . . . . . ft., From . . . . . ft. to . . . . . ft.  
 GRAVEL PACK INTERVALS: From 50 ft. to 74 ft., From . . . . . ft. to . . . . . ft.  
 From . . . . . ft. to . . . . . ft., From . . . . . ft. to . . . . . ft.

6 GROUT MATERIAL: 1 Neat cement  2 Cement grout  3 Bentonite  4 Other . . . . .  
 Grout intervals: From 1 ft. to 20 ft., From . . . . . ft. to . . . . . ft., From . . . . . ft. to . . . . . ft.

What is the nearest source of possible contamination:  
 1 Septic tank  4 Lateral lines  7 Pit privy  10 Livestock pens  14 Abandoned water well   
 2 Sewer lines  5 Cess pool  8 Sewage lagoon  11 Fuel storage  15 Oil well/Gas well   
 3 Watertight sewer lines  6 Seepage pit  9 Feedyard  12 Fertilizer storage  16 Other (specify below)   
 13 Insecticide storage   
 Direction from well? North How many feet? 45

FROM	TO	LITHOLOGIC LOG	FROM	TO	PLUGGING INTERVALS
0	10	top soil			
10	50	brown clay			
50	70	layer of brown clay with red & grey small futed sand			
70	74	shale			

7 CONTRACTOR'S OR LANDOWNER'S CERTIFICATION: This water well was  constructed,  reconstructed, or  plugged under my jurisdiction and was completed on (mo/day/year) 8/23/90 and this record is true to the best of my knowledge and belief. Kansas Water Well Contractor's License No. 276 This Water Well Record was completed on (mo/day/yr) 8/23/90 under the business name of huzar Water Well Drilling by (signature) Johnstone