


1 LOCATION OF WATER WELL: Fraction Section Number Township Number Range Number  
 County: Ellis NE 1/4 SE 1/4 SE 1/4 33 T 13 S R 18 **E/W**

Distance and direction from nearest town or city street address of well if located within city?  
 17th & Vine Streets, Hays, Ks. MW3

2 WATER WELL OWNER: Leroy Gottschalk  
 RR#, St. Address, Box # : P.O.Box 37 Board of Agriculture, Division of Water Resources  
 City, State, ZIP Code : Hays, Ks. 67601 Application Number:

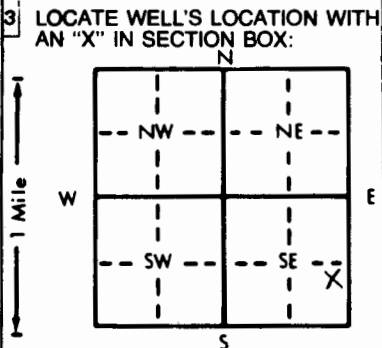

4 DEPTH OF COMPLETED WELL... 44 ft. ELEVATION: ...  
 Depth(s) Groundwater Encountered 1. 36 ft. 2. ... ft. 3. ... ft.  
 WELL'S STATIC WATER LEVEL . 33.24 ft. below land surface measured on mo/day/yr 3-27-92.  
 Pump test data: Well water was ... ft. after ... hours pumping ... gpm  
 Est. Yield ... gpm: Well water was ... ft. after ... hours pumping ... gpm  
 Bore Hole Diameter . 7 5/8 in. to . 44 ft., and ... in. to ... ft.  
 WELL WATER TO BE USED AS: 5 Public water supply 8 Air conditioning 11 Injection well  
 1 Domestic 3 Feedlot 6 Oil field water supply 9 Dewatering 12 Other (Specify below)  
 2 Irrigation 4 Industrial 7 Lawn and garden only **10 Monitoring well**  
 Was a chemical/bacteriological sample submitted to Department? Yes.....No...; If yes, mo/day/yr sample was sub-  
 mitted Water Well Disinfected? Yes No

5 TYPE OF BLANK CASING USED: 5 Wrought iron 8 Concrete tile CASING JOINTS: Glued ... Clamped ...  
 1 Steel 3 RMP (SR) 6 Asbestos-Cement 9 Other (specify below) Welded ...  
**2 PVC** 4 ABS 7 Fiberglass Threaded.   
 Blank casing diameter . 2 in. to . 29 ft., Dia. ... in. to ... ft., Dia. ... in. to ... ft.  
 Casing height above land surface . 0 in., weight ... lbs./ft. Wall thickness or gauge No. **Schedule 40**  
 TYPE OF SCREEN OR PERFORATION MATERIAL: **7 PVC** 10 Asbestos-cement  
 1 Steel 3 Stainless steel 5 Fiberglass 8 RMP (SR) 11 Other (specify) ...  
 2 Brass 4 Galvanized steel 6 Concrete tile 9 ABS 12 None used (open hole)  
 SCREEN OR PERFORATION OPENINGS ARE: 5 Gauzed wrapped 8 Saw cut 11 None (open hole)  
 1 Continuous slot **3 Mill slot** 6 Wire wrapped 9 Drilled holes  
 2 Louvered shutter 4 Key punched 7 Torch cut 10 Other (specify) ...  
 SCREEN-PERFORATED INTERVALS: From . 29 ft. to . 44 ft., From ... ft. to ... ft.  
 From ... ft. to ... ft., From ... ft. to ... ft.  
 GRAVEL PACK INTERVALS: From . 27 ft. to . 44 ft., From ... ft. to ... ft.  
 From ... ft. to ... ft., From ... ft. to ... ft.

6 GROUT MATERIAL: 1 Neat cement **2 Cement grout** **3 Bentonite** 4 Other ...  
 Grout intervals: From 0 ft. to 2 (cement) ft., From 2 ft. to 27 (bent) ft., From ... ft. to ... ft.  
 What is the nearest source of possible contamination:  
 1 Septic tank 4 Lateral lines 7 Pit privy **1 Fuel storage** 14 Abandoned water well  
 2 Sewer lines 5 Cess pool 8 Sewage lagoon 12 Fertilizer storage 15 Oil well/Gas well  
 3 Watertight sewer lines 6 Seepage pit 9 Feedyard 13 Insecticide storage 16 Other (specify below)  
 Direction from well? NW How many feet? 60

FROM	TO	LITHOLOGIC LOG	FROM	TO	PLUGGING INTERVALS
0	11	Sandy clay, brown			
11	15	Silt, brown, clayey			Flush Mount Cover
15	21.4	Sand, light brown, fine			KDHE Site #00098083
21.4	25	Clay, brown			
25	30	Sand, brown, fine			
30	35	Silty clay, brown to black			
35	41	Silty clay, greyish brown			
41	44	Sandy gravel, white to red			

7 CONTRACTOR'S OR LANDOWNER'S CERTIFICATION: This water well was (1) constructed, (2) reconstructed, or (3) plugged under my jurisdiction and was completed on (mo/day/year) 3-27-92 and this record is true to the best of my knowledge and belief. Kansas Water Well Contractor's License No. 527 This Water Well Record was completed on (mo/day/yr) 4-6-92 under the business name of GeoCore Services, Inc. by (signature) Dale Robb