


1 LOCATION OF WATER WELL: County: Ellis Fraction: NE 1/4 SE 1/4 SW 1/4 Section Number: 33 Township Number: T 13 S Range Number: R 18 EW

Distance and direction from nearest town or city street address of well if located within city?  
Don's 66 1302 Main Hays, Ks. 67601

2 WATER WELL OWNER: Dan & Carol Scheck  
 RR#, St. Address, Box #: 1302 Main Board of Agriculture, Division of Water Resources  
 City, State, ZIP Code: Hays, KS. 67601 Application Number:

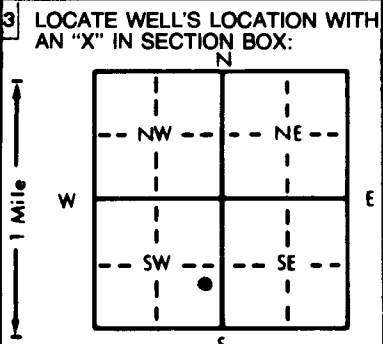

4 DEPTH OF COMPLETED WELL: 30' ft. ELEVATION: ..... ft.  
 Depth(s) Groundwater Encountered 1. 20' ft. 2. .... ft. 3. .... ft.  
 WELL'S STATIC WATER LEVEL: 18.91 ft. below land surface measured on mo/day/yr 2-17-94  
 Pump test data: Well water was ..... ft. after ..... hours pumping ..... gpm  
 Est. Yield ..... gpm: Well water was ..... ft. after ..... hours pumping ..... gpm  
 Bore Hole Diameter: 7 1/2" in. to 30' ft., and ..... in. to ..... ft.  
 WELL WATER TO BE USED AS:  
 5 Public water supply 8 Air conditioning 11 Injection well  
 1 Domestic 3 Feedlot 6 Oil field water supply 9 Dewatering 12 Other (Specify below)  
 2 Irrigation 4 Industrial 7 Lawn and garden only 10 Monitoring well  
 Was a chemical/bacteriological sample submitted to Department? Yes ..... No X .....; If yes, mo/day/yr sample was submitted  
 Water Well Disinfected? Yes No

5 TYPE OF BLANK CASING USED:  
 1 Steel 3 RMP (SR) 5 Wrought iron 8 Concrete tile CASING JOINTS: Glued ..... Clamped .....  
2 PVC 4 ABS 7 Fiberglass ..... Welded .....  
 Blank casing diameter 2.375 in. to 15' ft., Dia ..... in. to ..... ft., Dia ..... in. to ..... ft.  
 Casing height above land surface: Flush in., weight ..... lbs./ft. Wall thickness or gauge No. SDR 13  
 TYPE OF SCREEN OR PERFORATION MATERIAL:  
 1 Steel 3 Stainless steel 5 Fiberglass 8 RMP (SR) 10 Asbestos-cement SCH 40  
 2 Brass 4 Galvanized steel 6 Concrete tile 9 ABS 11 Other (specify) .....  
 12 None used (open hole)  
 SCREEN OR PERFORATION OPENINGS ARE:  
 1 Continuous slot 3 Mill slot 5 Gauzed wrapped 8 Saw cut 11 None (open hole)  
 2 Louvered shutter 4 Key punched 6 Wire wrapped 9 Drilled holes  
 7 Torch cut 10 Other (specify) .....  
 SCREEN-PERFORATED INTERVALS: From 30' ft. to 15' ft., From ..... ft. to ..... ft.  
 GRAVEL PACK INTERVALS: From 30' ft. to 12 1/2' ft., From ..... ft. to ..... ft.

6 GROUT MATERIAL: 1 Neat cement 2 Cement grout 3 Bentonite 4 Other  
 Grout Intervals: From 12 1/2' ft. to 4' ft., From 4' ft. to 0' ft., From ..... ft. to ..... ft.  
 What is the nearest source of possible contamination:  
 1 Septic tank 4 Lateral lines 7 Pit privy 10 Livestock pens 14 Abandoned water well  
 2 Sewer lines 5 Cess pool 8 Sewage lagoon 11 Fuel storage 15 Oil well/Gas well  
 3 Watertight sewer lines 6 Seepage pit 9 Feedyard 12 Fertilizer storage 16 Other (specify below)  
 13 Insecticide storage  
 Direction from well? Northwest How many feet? 250'

FROM	TO	LITHOLOGIC LOG	FROM	TO	PLUGGING INTERVALS
0	.50	Concrete			
.50	3.50	Dk. brn. silty clay, moist, no odor.			
3.50	11.50	Med. tan brn silty clay, moist, no odor.			
11.50	14	Med. tan brn silty sandy clay to sandy silt, moist, slight mottling w/ caliche chalky ls. No odor.			
14	25.50	fine-coarse grained sand & gravel, no odor.			
25.50	30	Dk. gray snad, strong odor.			

7 CONTRACTOR'S OR LANDOWNER'S CERTIFICATION: This water well was (1) constructed, (2) reconstructed, or (3) plugged under my jurisdiction and was completed on (mo/day/year) 2-17-94 and this record is true to the best of my knowledge and belief. Kansas Water Well Contractor's License No. 539 This Water Well Record was completed on (mo/day/yr) 2-26-94 under the business name of JB Environmental Drilling by (signature) James Bieber

OFFICE USE ONLY

T

R

EW

SEC

1/4

1/4

1/4