


1] LOCATION OF WATER WELL: County: Ellis Fraction: SE 1/4 SE 1/4 SW 1/4 Section Number: 33 Township Number: T 13 S Range Number: R 18 E

Distance and direction from nearest town or city street address of well if located within city?
Don's 66 1302 Main Hays, Ks. 67601

2] WATER WELL OWNER: Dan & Carol Scheck
 RR#, St. Address, Box #: 1302 Main
 City, State, ZIP Code: Hays, KS. 67601
 Board of Agriculture, Division of Water Resources
 Application Number: _____

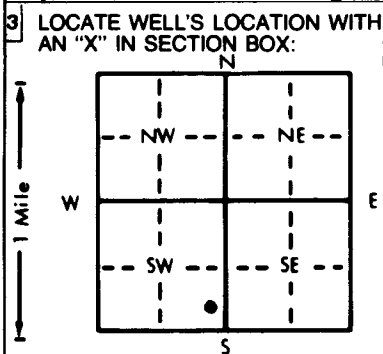

4] DEPTH OF COMPLETED WELL: 30' ft. ELEVATION: _____ ft.
 Depth(s) Groundwater Encountered: 1. 19' ft. 2. _____ ft. 3. _____ ft.
 WELL'S STATIC WATER LEVEL: 21.00 ft. below land surface measured on mo/day/yr 2-18-94
 Pump test data: Well water was _____ ft. after _____ hours pumping _____ gpm
 Est. Yield _____ gpm: Well water was _____ ft. after _____ hours pumping _____ gpm
 Bore Hole Diameter: 1 1/2" in. to 30' ft., and _____ in. to _____ ft.
 WELL WATER TO BE USED AS:
 5 Public water supply 8 Air conditioning 11 Injection well
 1 Domestic 3 Feedlot 6 Oil field water supply 9 Dewatering 12 Other (Specify below)
 2 Irrigation 4 Industrial 7 Lawn and garden only 10 Monitoring well
 Was a chemical/bacteriological sample submitted to Department? Yes _____ No X _____; If yes, mo/day/yr sample was submitted _____
 Water Well Disinfected? Yes _____ No (No) _____

5] TYPE OF BLANK CASING USED:
 1 Steel 3 RMP (SR) 5 Wrought iron 8 Concrete tile CASING JOINTS: Glued _____ Clamped _____
2 PVC 4 ABS 7 Fiberglass _____ Welded _____
 Blank casing diameter: 2.375 in. to 15' ft., Dia _____ in. to _____ ft., Dia _____ in. to _____ ft.
 Casing height above land surface: Flush Mount in., weight _____ lbs./ft. Wall thickness or gauge No. SDR 13
 TYPE OF SCREEN OR PERFORATION MATERIAL: 7 PVC 10 Asbestos-cement SCH 40
 1 Steel 3 Stainless steel 5 Fiberglass 8 RMP (SR) 11 Other (specify) _____
 2 Brass 4 Galvanized steel 6 Concrete tile 9 ABS 12 None used (open hole)
 SCREEN OR PERFORATION OPENINGS ARE:
 1 Continuous slot 3 Mill slot 5 Gauzed wrapped 8 Saw cut 11 None (open hole)
 2 Louvered shutter 4 Key punched 6 Wire wrapped 9 Drilled holes
 7 Torch cut 10 Other (specify) _____
 SCREEN-PERFORATED INTERVALS: From 30' ft. to 15' ft., From _____ ft. to _____ ft.
 GRAVEL PACK INTERVALS: From 30' ft. to 12 1/2' ft., From _____ ft. to _____ ft.

6] GROUT MATERIAL: 1 Neat cement 2 Cement grout 3 Bentonite 4 Other _____
 Grout Intervals: From 12 1/2' ft. to 5' ft., From 5' ft. to 0' ft., From _____ ft. to _____ ft.
 What is the nearest source of possible contamination:
 1 Septic tank 4 Lateral lines 7 Pit privy 11 Fuel storage Farm 14 Abandoned water well
2 Sewer lines 5 Cess pool 8 Sewage lagoon 12 Fertilizer storage 16 Other (specify below)
 3 Watertight sewer lines 6 Seepage pit 9 Feedyard 13 Insecticide storage
 Direction from well? Sewer - South (W) North West How many feet? 15' 11 - 450'

FROM	TO	LITHOLOGIC LOG	FROM	TO	PLUGGING INTERVALS
0	.50	Asphalt			
.50	6.50	Dk. brn soft silty clay, moist to wet. No odor, iron stained.			
6.50	13.25	Med. tannish brn silty clay, moist, friable, no odor.			
13.25	19	Pale gray- gray brn. mottled clayey sandy silt, moist, soft, no odor, fine grained sand.			
19	30	Fine coarse grained sand, subrounded, wet, no odor.			

7] CONTRACTOR'S OR LANDOWNER'S CERTIFICATION: This water well was (1) constructed, (2) reconstructed, or (3) plugged under my jurisdiction and was completed on (mo/day/year) 2-18-94 and this record is true to the best of my knowledge and belief. Kansas Water Well Contractor's License No. 539. This Water Well Record was completed on (mo/day/yr) 2-26-94 under the business name of JB Environmental Drilling by (signature) James Baker

OFFICE USE ONLY