


1 LOCATION OF WATER WELL: Fraction NE 1/4 SE 1/4 SW 1/4 Section Number 33 Township Number T 13 S Range Number R 18 EW
 County: Ellis

Distance and direction from nearest town or city street address of well if located within city?
Don's 66 1302 Main Hays, Ks. 67601

2 WATER WELL OWNER: Dan & Carol Scheck
 RR#, St. Address, Box #: 1302 Main Board of Agriculture, Division of Water Resources
 City, State, ZIP Code: Hays, KS. 67601 Application Number:

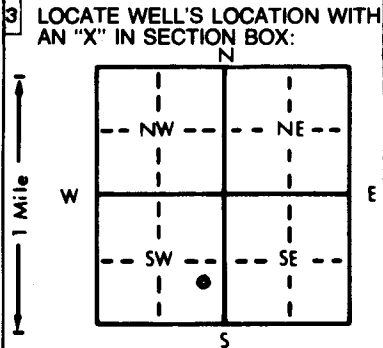

4 DEPTH OF COMPLETED WELL: 30' ft. ELEVATION: ft.
 Depth(s) Groundwater Encountered 1. 19' ft. 2. ft. 3. ft.
 WELL'S STATIC WATER LEVEL 20.80 ft. below land surface measured on mo/day/yr 2-18-94
 Pump test data: Well water was ft. after hours pumping gpm
 Est. Yield gpm: Well water was ft. after hours pumping gpm
 Bore Hole Diameter: 7 1/2" in. to 30' ft., and in. to ft.
 WELL WATER TO BE USED AS:
 5 Public water supply 8 Air conditioning 11 Injection well
 1 Domestic 3 Feedlot 6 Oil field water supply 9 Dewatering 12 Other (Specify below)
 2 Irrigation 4 Industrial 7 Lawn and garden only 10 Monitoring well
 Was a chemical/bacteriological sample submitted to Department? Yes No X; If yes, mo/day/yr sample was submitted
 Water Well Disinfected? Yes No

5 TYPE OF BLANK CASING USED:
 1 Steel 3 RMP (SR) 5 Wrought iron 8 Concrete tile CASING JOINTS: Glued Clamped
2 PVC 4 ABS 6 Asbestos-Cement 9 Other (specify below) Welded
 7 Fiberglass Threaded X
 Blank casing diameter 2.375 in. to ft., Dia in. to ft., Dia in. to ft.
 Casing height above land surface Flush Mount in., weight lbs./ft. Wall thickness or gauge No. SDR 13
 TYPE OF SCREEN OR PERFORATION MATERIAL: 7 PVC 10 Asbestos-cement SCH 40
 1 Steel 3 Stainless steel 5 Fiberglass 8 RMP (SR) 11 Other (specify)
 2 Brass 4 Galvanized steel 6 Concrete tile 9 ABS 12 None used (open hole)
 SCREEN OR PERFORATION OPENINGS ARE:
 1 Continuous slot 3 Mill slot 5 Gauzed wrapped 8 Saw cut 11 None (open hole)
 2 Louvered shutter 4 Key punched 6 Wire wrapped 9 Drilled holes
 7 Torch cut 10 Other (specify)
 SCREEN-PERFORATED INTERVALS: From 30' ft. to 15' ft., From ft. to ft.
 From ft. to ft., From ft. to ft.
 GRAVEL PACK INTERVALS: From 30' ft. to 10 1/2' ft., From ft. to ft.
 From ft. to ft., From ft. to ft.

6 GROUT MATERIAL: 1 Neat cement 2 Cement grout 3 Bentonite 4 Other
 Grout Intervals: From 12 1/2' ft. to 5' ft., From 5' ft. to 0' ft., From ft. to ft.
 What is the nearest source of possible contamination:
 1 Septic tank 4 Lateral lines 7 Pit privy 11 Fuel storage 14 Abandoned water well
 2 Sewer lines 5 Cess pool 8 Sewage lagoon 12 Fertilizer storage 15 Oil well/Gas well
 3 Watertight sewer lines 6 Seepage pit 9 Feedyard 13 Insecticide storage 16 Other (specify below)
 Direction from well? Southeast How many feet? 100'

FROM	TO	LITHOLOGIC LOG	FROM	TO	PLUGGING INTERVALS
0	.50	Concrete			
.50	10.50	Med - light brn silty clay, moist, earthy odor, friable.			
10.50	14	Dk med. brn clay, moist, friable, no odor.			
14	16	Gray-gray brn silt, soft, moist, no odor.			
16	19	Gray sandy silt to silty sand, moist, no odor. Slight dk brn banding			
19	30	Fine-coarse grained sand, tan to lt gray, wet, no odor.			

7 CONTRACTOR'S OR LANDOWNER'S CERTIFICATION: This water well was (1) constructed, (2) reconstructed, or (3) plugged under my jurisdiction and was completed on (mo/day/year) 2-18-94 and this record is true to the best of my knowledge and belief. Kansas Water Well Contractor's License No. 539 This Water Well Record was completed on (mo/day/yr) 2-26-94 under the business name of JB Environmental Drilling by (signature) James Baker

OFFICE USE ONLY
T
R
EW
SEC.