


WATER WELL RECORD Form WWC-5 KSA 82a-1212

1 LOCATION OF WATER WELL: County: Ellis	Fraction SW ¼ NW ¼ SE ¼	Section Number 33	Township Number T 13 S	Range Number R 18	SEW
--	----------------------------	----------------------	---------------------------	----------------------	-----

Distance and direction from nearest town or city street address of well if located within city?
1405 East 17th Hays, KS 67601

2 WATER WELL OWNER: Rob Disney
 RR#, St. Address, Box #: 1405 East 17th
 City, State, ZIP Code: Hays, KS 67601
 Board of Agriculture, Division of Water Resources
 Application Number:

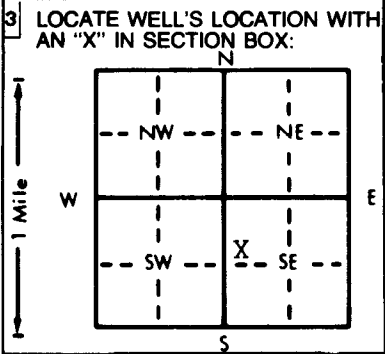

4 DEPTH OF COMPLETED WELL: 68 ft. ELEVATION: Upland
 Depth(s) Groundwater Encountered 1. 49 ft. 2. ft. 3. ft.
 WELL'S STATIC WATER LEVEL: 24 ft. below land surface measured on mo/day/yr 4/5/94
 Pump test data: Well water was 53 ft. after 1 hours pumping 20 gpm
 Est. Yield gpm: Well water was ft. after hours pumping gpm
 Bore Hole Diameter: 10 in. to 68 ft., and in. to ft.
 WELL WATER TO BE USED AS:
 7 5 Public water supply 8 Air conditioning 11 Injection well
 1 Domestic 3 Feedlot 6 Oil field water supply 9 Dewatering 12 Other (Specify below)
 2 Irrigation 4 Industrial 7 Lawn and garden only 10 Monitoring well
 Was a chemical/bacteriological sample submitted to Department? Yes No X; If yes, mo/day/yr sample was submitted Water Well Disinfected? Yes X No

5 TYPE OF BLANK CASING USED:
 1 Steel 2 PVC 3 RMP (SR) 4 ABS 5 Wrought iron 6 Asbestos-Cement 7 Fiberglass 8 Concrete tile 9 Other (specify below)
 CASING JOINTS: Glued X Clamped Welded Threaded
 Blank casing diameter 5 in. to 48 ft., Dia in. to ft., Dia in. to ft.
 Casing height above land surface 24 in., weight 2,29 lbs./ft. Wall thickness or gauge No. 26
 TYPE OF SCREEN OR PERFORATION MATERIAL: 7 PVC 10 Asbestos-cement
 1 Steel 2 Brass 3 Stainless steel 4 Galvanized steel 5 Fiberglass 6 Concrete tile 8 RMP (SR) 9 ABS 11 Other (specify) 12 None used (open hole)
 SCREEN OR PERFORATION OPENINGS ARE: 8 5 Gauzed wrapped 8 Saw cut 11 None (open hole)
 1 Continuous slot 2 Louvered shutter 3 Mill slot 4 Key punched 6 Wire wrapped 7 Torch cut 9 Drilled holes 10 Other (specify)
 SCREEN-PERFORATED INTERVALS: From 68 ft. to 48 ft., From ft. to ft.
 GRAVEL PACK INTERVALS: From 20 ft. to 68 ft., From ft. to ft.

6 GROUT MATERIAL: 3 1 Neat cement 2 Cement grout 3 Bentonite 4 Other
 Grout Intervals: From 0 ft. to 20 ft., From ft. to ft.
 What is the nearest source of possible contamination: NONE
 1 Septic tank 2 Sewer lines 3 Watertight sewer lines 4 Lateral lines 5 Cess pool 6 Seepage pit 7 Pit privy 8 Sewage lagoon 9 Feedyard 10 Livestock pens 11 Fuel storage 12 Fertilizer storage 13 Insecticide storage 14 Abandoned water well 15 Oil well/Gas well 16 Other (specify below)
 Direction from well? How many feet?

FROM	TO	LITHOLOGIC LOG	FROM	TO	PLUGGING INTERVALS
0	2	Topsoil			
2	10	Gumbo			
10	15	Gumbo, some loose rock			
15	49	Gumbo			
49	56	Sand, shale mix			
56	58	Clay, mud			
58	68	Shale			

7 CONTRACTOR'S OR LANDOWNER'S CERTIFICATION: This water well was (1) constructed, (2) reconstructed, or (3) plugged under my jurisdiction and was completed on (mo/day/year) 4/5/94 and this record is true to the best of my knowledge and belief. Kansas Water Well Contractor's License No. 199 This Water Well Record was completed on (mo/day/yr) 4/8/94 under the business name of Karst Water Well Drilling & Service, Inc. by (signature)

INSTRUCTIONS: Use typewriter or ball point pen. PLEASE PRESS FIRMLY and PRINT clearly. Please fill in blanks, underline or circle the correct answers. Send top three copies to Kansas Department of Health and Environment, Bureau of Water, Topeka, Kansas 66620-0001. Telephone: 913-296-5545. Send one to WATER WELL OWNER and retain one for your records.