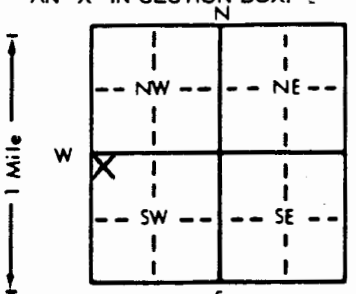


| | | | | |
|--|----------------------------------|----------------------|---------------------------|-------------------------|
| 1 LOCATION OF WATER WELL: County: Ellis | Fraction NW 1/4 NW 1/4 SW 1/4 | Section Number 34 | Township Number T 13 S | Range Number R 18 EW |
|--|----------------------------------|----------------------|---------------------------|-------------------------|

Distance and direction from nearest town or city street address of well if located within city?

2605 Vine Street, Hays, Kansas 67601

| | | |
|---|--|--|
| 2 WATER WELL OWNER: RR#, St. Address, Box # : City, State, ZIP Code : | Love's Country Store 2605 Vine Street Hays, Kansas 67601 | Board of Agriculture, Division of Water Resources Application Number: |
|---|--|--|

| | |
|--|---|
| 3 LOCATE WELL'S LOCATION WITH AN "X" IN SECTION BOX:  | 4 DEPTH OF COMPLETED WELL: 65 ft. ELEVATION: |
| | Depth(s) Groundwater Encountered 1. 50 ft. 2. ft. 3. ft. WELL'S STATIC WATER LEVEL ft. below land surface measured on mo/day/yr Pump test data: Well water was ft. after hours pumping gpm Est. Yield gpm: Well water was ft. after hours pumping gpm Bore Hole Diameter 7.5/8 in. to 65 ft., and in. to ft. WELL WATER TO BE USED AS: 1 Domestic 3 Feedlot 6 Oil field water supply 9 Dewatering 12 Other (Specify below) 2 Irrigation 4 Industrial 7 Lawn and garden only 10 Monitoring well Was a chemical/bacteriological sample submitted to Department? Yes No <input checked="" type="checkbox"/> ; If yes, mo/day/yr sample was submitted Water Well Disinfected? Yes No <input checked="" type="checkbox"/> |

| | | | |
|---|--------------------|-------------------|--|
| 5 TYPE OF BLANK CASING USED: | 5 Wrought iron | 8 Concrete tile | CASING JOINTS: Glued Clamped |
| 1 Steel | 3 RMP (SR) | 6 Asbestos-Cement | 9 Other (specify below) |
| 2 PVC | 4 ABS | 7 Fiberglass | Welded |
| Blank casing diameter 2 in. to 45 ft., Dia in. to ft., Dia in. to ft. | | | Threaded <input checked="" type="checkbox"/> |
| Casing height above land surface 0 in., weight lbs./ft. Wall thickness or gauge No. Sch. 40 | | | |
| TYPE OF SCREEN OR PERFORATION MATERIAL: | | 7 PVC | 10 Asbestos-cement |
| 1 Steel | 3 Stainless steel | 5 Fiberglass | 8 RMP (SR) |
| 2 Brass | 4 Galvanized steel | 6 Concrete tile | 9 ABS |
| SCREEN OR PERFORATION OPENINGS ARE: | | 5 Gauzed wrapped | 8 Saw cut |
| 1 Continuous slot | 3 Mill slot | 6 Wire wrapped | 9 Drilled holes |
| 2 Louvered shutter | 4 Key punched | 7 Torch cut | 10 Other (specify) |
| SCREEN-PERFORATED INTERVALS: From 65 ft. to 45 ft., From ft. to ft. | | | |
| GRAVEL PACK INTERVALS: From 65 ft. to 43 ft., From ft. to ft. | | | |

| | | | | |
|---|-----------------|-----------------|------------------------|--------------------------|
| 6 GROUT MATERIAL: | 1 Neat cement | 2 Cement grout | 3 Bentonite | 4 Other |
| Grout Intervals: From 0 ft. to 43 ft., From 43 ft. to 41 ft., From ft. to ft. | | | | |
| What is the nearest source of possible contamination: | | | 10 Livestock pens | 14 Abandoned water well |
| 1 Septic tank | 4 Lateral lines | 7 Pit privy | 11 Fuel storage | 15 Oil well/Gas well |
| 2 Sewer lines | 5 Cess pool | 8 Sewage lagoon | 12 Fertilizer storage | 16 Other (specify below) |
| 3 Watertight sewer lines | 6 Seepage pit | 9 Feedyard | 13 Insecticide storage | |
| Direction from well? north | | | How many feet? 5 | |

| FROM | TO | LITHOLOGIC LOG | FROM | TO | PLUGGING INTERVALS |
|------|------|--|------|----|--------------------|
| 0 | 4" | ASPHALT | | | Flush mount cover |
| 4" | 2' | CLY MOD BRN, W/V LT BRN SLTY LOESS, SL SLTY, SL SNDY | | | |
| 2 | 14 | CLY, LT TO MOD BRN, MOD SLTY, TR SND & CLAC CLSTS | | | OBW2 |
| 14 | 28 | RED BRN CLY, MOD SLTY, TR CALC MAT | 62.5 | 65 | DRK GRY-GRN SHALE |
| 28 | 35 | LT TO MD BRN CLY, MOD TO V SLTY, TR CALC MAT | | | |
| 35 | 40 | SILT, V CLYEY, DAMP | | | |
| 40 | 43 | CLY, MOD DRK BRN, V SLTY, TR V F SND | | | |
| 43 | 47 | CLY, GRY DISC V SLTY, SL SNDY, F TO MED GRN | | | |
| 47 | 62.5 | CLY, MD BRN, V SLTY, MOD SND, F TO MED GRN | | | |

| |
|--|
| 7 CONTRACTOR'S OR LANDOWNER'S CERTIFICATION: This water well was (1) constructed, (2) reconstructed, or (3) plugged under my jurisdiction and was completed on (mo/day/year) 09-22-93 and this record is true to the best of my knowledge and belief. Kansas Water Well Contractor's License No. 527 This Water Well Record was completed on (mo/day/yr) 10-01-93 under the business name of GeoCore Services, Inc. by (signature) Dale Rolt |
|--|