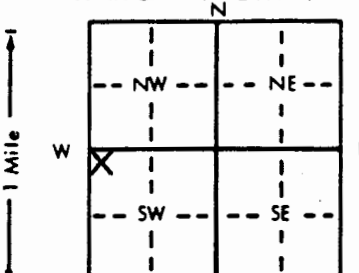


1 LOCATION OF WATER WELL: County: Ellis Fraction NW 1/4 NW 1/4 SW 1/4 Section Number 34 Township Number T 13 S Range Number R 18 EW

Distance and direction from nearest town or city street address of well if located within city?
2605 Vine Street, Hays, Kansas 67601

2 WATER WELL OWNER: Love's Country Store
RR#, St. Address, Box #: 2605 Vine Street Board of Agriculture, Division of Water Resources
City, State, ZIP Code: Hays, Kansas 67601 Application Number:

3 LOCATE WELL'S LOCATION WITH AN "X" IN SECTION BOX:  4 DEPTH OF COMPLETED WELL: 65 ft. ELEVATION:
Depth(s) Groundwater Encountered 1. 50 ft. 2. ft. 3. ft.
WELL'S STATIC WATER LEVEL ft. below land surface measured on mo/day/yr
Pump test data: Well water was ft. after hours pumping gpm
Est. Yield gpm: Well water was ft. after hours pumping gpm
Bore Hole Diameter: 7 5/8 in. to 65 ft., and in. to ft.
WELL WATER TO BE USED AS: 5 Public water supply 8 Air conditioning 11 Injection well
1 Domestic 3 Feedlot 6 Oil field water supply 9 Dewatering 12 Other (Specify below)
2 Irrigation 4 Industrial 7 Lawn and garden only 10 Monitoring well
Was a chemical/bacteriological sample submitted to Department? Yes No ; If yes, mo/day/yr sample was submitted Water Well Disinfected? Yes No

5 TYPE OF BLANK CASING USED: 1 Steel 2 PVC 3 RMP (SR) 4 ABS 5 Wrought iron 6 Asbestos-Cement 7 Fiberglass 8 Concrete tile 9 Other (specify below) CASING JOINTS: Glued Clamped Welded Threaded
Blank casing diameter 2 in. to 45 ft., Dia in. to ft., Dia in. to ft.
Casing height above land surface 0 in., weight lbs./ft. Wall thickness or gauge No. Sch. 40
TYPE OF SCREEN OR PERFORATION MATERIAL: 1 Steel 2 Brass 3 Stainless steel 4 Galvanized steel 5 Fiberglass 6 Concrete tile 7 PVC 8 RMP (SR) 9 ABS 10 Asbestos-cement 11 Other (specify) 12 None used (open hole)
SCREEN OR PERFORATION OPENINGS ARE: 1 Continuous slot 2 Louvered shutter 3 Mill slot 4 Key punched 5 Gauzed wrapped 6 Wire wrapped 7 Torch cut 8 Saw cut 9 Drilled holes 10 Other (specify) 11 None (open hole)
SCREEN-PERFORATED INTERVALS: From 65 ft. to 45 ft., From ft. to ft.
GRAVEL PACK INTERVALS: From 65 ft. to 42.5 ft., From ft. to ft.

6 GROUT MATERIAL: 1 Neat cement 2 Cement grout 3 Bentonite 4 Other
Grout Intervals: From 0 ft. to 40.5 ft., From 40.5 ft. to 42.5 ft., From ft. to ft.
What is the nearest source of possible contamination: 1 Septic tank 2 Sewer lines 3 Watertight sewer lines 4 Lateral lines 5 Cess pool 6 Seepage pit 7 Pit privy 8 Sewage lagoon 9 Feedyard 10 Livestock pens 11 Fuel storage 12 Fertilizer storage 13 Insecticide storage 14 Abandoned water well 15 Oil well/Gas well 16 Other (specify below)
Direction from well? south How many feet? 24

FROM	TO	LITHOLOGIC LOG	FROM	TO	PLUGGING INTERVALS
0	4"	ASPHALT			Flush mount cover
4"	6'	CLY, MD BRN, SL SND, F TO MD GRN, CALIC DAMP, TR SND & CALIC			
6	15	LT BRN CLY, MOTTLED RED, SL SLTY, TR CALC CLSTS			MW5
15	24	LT BRN CLY, MOTTLED RED, SL SLTY, TR CALC CLSTS, REDDISH BRN COLOR	62	64	SHALE, V DK BRN, ORG RICH, V HARD
24	35	LT BRN CLY, MOTTLED RED, SL SLTY, TR CALC CLSTS, REDDISH BRN COLOR, W/SL CLSTS LM, CHERT LAYER OF 2" @ 27'	64	65	DK GRY TO V DK BRN SHALE MOD HARD
35	40	SLT, V CLYEY TR V F SND, V LT BRN COLOR			
40	62	CLY, MD BRN, TINT OF RED, V SLTY, TR V F SND			

7 CONTRACTOR'S OR LANDOWNER'S CERTIFICATION: This water well was (1) constructed, (2) reconstructed, or (3) plugged under my jurisdiction and was completed on (mo/day/year) 09-23-93 and this record is true to the best of my knowledge and belief. Kansas Water Well Contractor's License No. 527 This Water Well Record was completed on (mo/day/yr) 10-01-93 under the business name of GeoCore Services, Inc. by (signature) Dale Bell