


1 LOCATION OF WATER WELL: County: Ellis Fraction NW 1/4 NW 1/4 SW 1/4 Section Number 34 Township Number T 13 S Range Number R 18 EW

Distance and direction from nearest town or city street address of well if located within city?

2605 Vine Street, Hays, Kansas 67601

2 WATER WELL OWNER: Love's Country Store  
 RR#, St. Address, Box #: 2605 Vine Street  
 City, State, ZIP Code: Hays, Kansas 67601  
 Board of Agriculture, Division of Water Resources  
 Application Number:

3 LOCATE WELL'S LOCATION WITH AN "X" IN SECTION BOX:

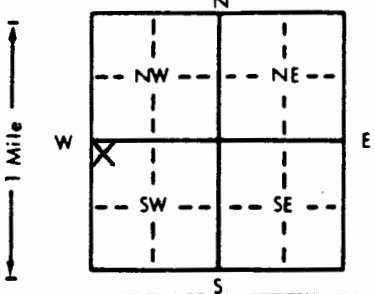

4 DEPTH OF COMPLETED WELL: 65 ft. ELEVATION:  
 Depth(s) Groundwater Encountered 1. 50 ft. 2. ft. 3. ft.  
 WELL'S STATIC WATER LEVEL: ft. below land surface measured on mo/day/yr  
 Pump test data: Well water was ft. after hours pumping gpm  
 Est. Yield gpm: Well water was ft. after hours pumping gpm  
 Bore Hole Diameter: 7 5/8 in. to 65 ft., and in. to ft.  
 WELL WATER TO BE USED AS:  
 5 Public water supply 8 Air conditioning 11 Injection well  
 1 Domestic 3 Feedlot 6 Oil field water supply 9 Dewatering 12 Other (Specify below)  
 2 Irrigation 4 Industrial 7 Lawn and garden only 10 Monitoring well  
 Was a chemical/bacteriological sample submitted to Department? Yes No  If yes, mo/day/yr sample was submitted  
 Water Well Disinfected? Yes No

5 TYPE OF CASING USED:  
 1 Steel 3 RMP (SR) 5 Wrought iron 8 Concrete tile CASING JOINTS: Glued Clamped  
 2 PVC 4 ABS 6 Asbestos-Cement 9 Other (specify below) Welded  
 7 Fiberglass Threaded   
 Blank casing diameter: 2 in. to 45 ft., Dia in. to ft., Dia in. to ft.  
 Casing height above land surface: 0 in., weight lbs./ft. Wall thickness or gauge No. Sch. 40  
 TYPE OF SCREEN OR PERFORATION MATERIAL:  
 1 Steel 3 Stainless steel 5 Fiberglass 8 RMP (SR) 10 Asbestos-cement  
 2 Brass 4 Galvanized steel 6 Concrete tile 9 ABS 11 Other (specify)  
 12 None used (open hole)  
 SCREEN OR PERFORATION OPENINGS ARE:  
 1 Continuous slot 3 Mill slot 5 Gauzed wrapped 8 Saw cut 11 None (open hole)  
 2 Louvered shutter 4 Key punched 6 Wire wrapped 9 Drilled holes  
 7 Torch cut 10 Other (specify)  
 SCREEN-PERFORATED INTERVALS: From 65 ft. to 45 ft., From ft. to ft.  
 GRAVEL PACK INTERVALS: From 65 ft. to 35 ft., From ft. to ft.

6 GROUT MATERIAL: 1 Neat cement 2 Cement grout 3 Bentonite 4 Other  
 Grout Intervals: From 0 ft. to 17 ft., From 17 ft. to 35 ft., From ft. to ft.  
 What is the nearest source of possible contamination:  
 1 Septic tank 4 Lateral lines 7 Pit privy 10 Livestock pens 14 Abandoned water well  
 2 Sewer lines 5 Cess pool 8 Sewage lagoon 11 Fuel storage 15 Oil well/Gas well  
 3 Watertight sewer lines 6 Seepage pit 9 Feedyard 12 Fertilizer storage 16 Other (specify below)  
 13 Insecticide storage  
 Direction from well? north How many feet? 5

FROM	TO	LITHOLOGIC LOG	FROM	TO	PLUGGING INTERVALS
0	6"	ASPHALT			Flush mount cover
6"	2'	CLY, MOD BRN WITH V LT BRN SLTY			
		LOESS, SL SLTY & SNDY, TR GRVL			PTW
2	28	CLY, LT TO MD BRN, MOD SLTY, TR			
		SND & CALIC CLSTS			
28	35	LT TO MD BRN CLY, MOD TO V SLTY,			
		TR CALC MAT			
35	40	SILT, V CLYEY, DAMP			
40	43	CLY, MD DRK BRN, V SLTY, TR V F			
		SND			
43	47	GRY DISCOLORED CLY, V SLTY, SL			
		AMOUNT F TO MD SND			
47	62.5	MD BRN CLY, V SLTY, MOD F TO MD			
		GRN SND			
62.5	65	DRK GRY-GRN SHALE			

7 CONTRACTOR'S OR LANDOWNER'S CERTIFICATION: This water well was (1) constructed, (2) reconstructed, or (3) plugged under my jurisdiction and was completed on (mo/day/year) 09-28-93 and this record is true to the best of my knowledge and belief. Kansas Water Well Contractor's License No. 527 This Water Well Record was completed on (mo/day/yr) 10-01-93 under the business name of GeoCore Services, Inc. by (signature) Paul Bell

INSTRUCTIONS: Use typewriter or ball point pen. PLEASE PRESS FIRMLY and PRINT clearly. Please fill in blanks, underline or circle the correct answers. Send top three copies to Kansas Department of Health and Environment, Bureau of Water, Topeka, Kansas 66620-0001. Telephone: 913-296-5545. Send one to WATER WELL OWNER and retain one for your records.