


1 LOCATION OF WATER WELL: County: **Ellis** Fraction: **NE 1/4 NW 1/4 NW 1/4** Section Number: **34** Township Number: **T 13 S** Range Number: **18 E/W**

Distance and direction from nearest town or city street address of well if located within city?
SE corner of Broadway & 27th Street

2 WATER WELL OWNER: **Henry Schwaller, Jr. - Frontier Quick Mart**
 RR#, St. Address, Box # : **1500 Vine** Board of Agriculture, Division of Water Resources
 City, State, ZIP Code : **Hays, Ks. 67601** Application Number:

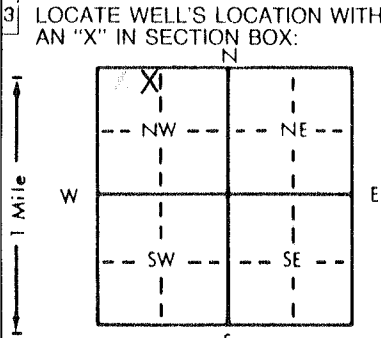

4 DEPTH OF COMPLETED WELL: **30** ft. ELEVATION: **NA**

Depth(s) Groundwater Encountered 1. **25** ft. 2. . ft. 3. . ft.

WELL'S STATIC WATER LEVEL: **24.92** ft. below land surface measured on mo/day/yr **04-18-94**

Pump test data: Well water was . ft. after . hours pumping . gpm
 Est. Yield . gpm: Well water was . ft. after . hours pumping . gpm
 Bore Hole Diameter: **7 5/8** in. to **30** ft., and . in. to . ft.

WELL WATER TO BE USED AS:
 5 Public water supply 8 Air conditioning 11 Injection well
 1 Domestic 3 Feedlot 6 Oil field water supply 9 Dewatering 12 Other (Specify below)
 2 Irrigation 4 Industrial 7 Lawn and garden only **10** Monitoring well

Was a chemical/bacteriological sample submitted to Department? Yes . No **X** ; If yes, mo/day/yr sample was submitted
 Water Well Disinfected? Yes . No **X**

5 TYPE OF BLANK CASING USED:
 1 Steel 3 RMP (SR) 5 Wrought iron 8 Concrete tile CASING JOINTS: Glued . Clamped .
 2 **PVC** 4 ABS 6 Asbestos-Cement 9 Other (specify below) Welded .
 7 Fiberglass . Threaded **X**

Blank casing diameter: **2** in. to **15** ft., Dia . in. to . ft., Dia . in. to . ft.
 Casing height above land surface: **0** in., weight . lbs./ft. Wall thickness or gauge No. **sch. 40**

TYPE OF SCREEN OR PERFORATION MATERIAL:
 1 Steel 3 Stainless steel 5 Fiberglass **7** PVC 10 Asbestos-cement
 2 Brass 4 Galvanized steel 6 Concrete tile 8 RMP (SR) 11 Other (specify) .
 9 ABS 12 None used (open hole)

SCREEN OR PERFORATION OPENINGS ARE:
 1 Continuous slot **3** Mill slot 5 Gauzed wrapped 8 Saw cut 11 None (open hole)
 2 Louvered shutter 4 Key punched 6 Wire wrapped 9 Drilled holes
 7 Torch cut 10 Other (specify) .

SCREEN-PERFORATED INTERVALS: From **30** ft. to **15** ft., From . ft. to . ft.
 From . ft. to . ft., From . ft. to . ft.

GRAVEL PACK INTERVALS: From **30** ft. to **13** ft., From . ft. to . ft.
 From . ft. to . ft., From . ft. to . ft.

6 GROUT MATERIAL: 1 Neat cement **2** Cement grout **3** Bentonite 4 Other .
 Grout Intervals: From **0** ft. to **11** ft., From **11** ft. to **13** ft., From . ft. to . ft.

What is the nearest source of possible contamination:
 1 Septic tank 4 Lateral lines 7 Pit privy **11** Fuel storage 14 Abandoned water well
 2 Sewer lines 5 Cess pool 8 Sewage lagoon 12 Fertilizer storage 15 Oil well/Gas well
 3 Watertight sewer lines 6 Seepage pit 9 Feedyard 13 Insecticide storage 16 Other (specify below)

Direction from well? **northwest** How many feet? **255**

FROM	TO	LITHOLOGIC LOG	FROM	TO	PLUGGING INTERVALS
0	2'	cly, (topsoil) drk brn, mod slty, org rich			
2'	6'	cly, med-brn, v slty, mod snd-grvl szd calic			
6'	20	cly, lt brn w/oran tint, v slty, sl snd szd calic			
20	30	cly, med oran brn, sl snd szd calic, semiplstc			

I.D. # 102647
 MW8-flush mount cover

7 CONTRACTOR'S OR LANDOWNER'S CERTIFICATION: This water well was **(1)** constructed, (2) reconstructed, or (3) plugged under my jurisdiction and was completed on (mo/day/year) **04-12-94** and this record is true to the best of my knowledge and belief. Kansas Water Well Contractor's License No. **527** This Water Well Record was completed on (mo/day/yr) **04-21-94** under the business name of **GedCore Services, Inc.** by (signature) *[Signature]*

INSTRUCTIONS: Use typewriter or ball point pen. PLEASE PRESS FIRMLY and PRINT clearly. Please fill in blanks, underline or circle the correct answers. Send top three copies to Kansas Department of Health and Environment, Bureau of Water, Topeka, Kansas 66620-0001. Telephone: 913-296-5545. Send one to WATER WELL OWNER and retain one for your records.