


1 LOCATION OF WATER WELL:		Fraction	Section Number	Township Number	Range Number
County:	Ellis	$\frac{1}{4}$ SW $\frac{1}{4}$ SW $\frac{1}{4}$	34	T 13 S	R 18 E/W

Distance and direction from nearest town or city street address of well if located within city?

~~30' east of Vine, south side of 13th Street, Hays, Ks.~~

2	WATER WELL OWNER:	Five Star Amoco	
	RR#, St. Address, Box # :	1300 Vine Street	Board of Agriculture, Division of Water Resources
	City, State, ZIP Code :	Hays, Kansas	Application Number:

3 LOCATE WELL'S LOCATION WITH AN "X" IN SECTION BOX: 4 DEPTH OF COMPLETED WELL... 35 ft. ELEVATION: NA

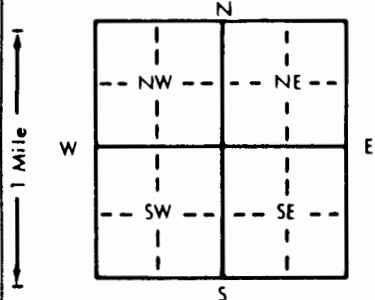

4) DEPTH OF COMPLETED WELL..... 35 ..... ft. ELEVATION: NA .....  
 Depth(s) Groundwater Encountered 1. 23 ..... ft. 2. .... ft. 3. .... ft.  
 WELL'S STATIC WATER LEVEL ..... ft. below land surface measured on mo/day/yr .....  
 Pump test data: Well water was ..... ft. after ..... hours pumping ..... gpm  
 Est. Yield ..... gpm: Well water was ..... ft. after ..... hours pumping ..... gpm  
 Bore Hole Diameter . 8. .... in. to ..... 35 ..... ft., and ..... in. to ..... ft.  
 WELL WATER TO BE USED AS: 5 Public water supply 8 Air conditioning 11 Injection well  
 1 Domestic 3 Feedlot 6 Oil field water supply 9 Dewatering 12 Other (Specify below)  
 2 Irrigation 4 Industrial 7 Lawn and garden only 10 Monitoring well  
 Was a chemical/bacteriological sample submitted to Department? Yes ..... No. X .....; If yes, mo/day/yr sample was sub-  
 mitted Water Well Disinfected? Yes No X

5	TYPE OF BLANK CASING USED:	5 Wrought iron	8 Concrete tile	CASING JOINTS: Glued . . . . . Clamped . . . . .
	1 Steel	6 Asbestos-Cement	9 Other (specify below)	Welded . . . . .
	2 PVC	7 Fiberglass		Threaded. <input checked="" type="checkbox"/> . . . . .
	3 RMP (SR)			
	4 ABS			

Blank casing diameter . . . . . **2** . . . in. to . . . **19.5** . . . ft., Dia . . . in. to . . . . . ft., Dia . . . in. to . . . . . ft.  
Casing height above land surface . . . . . **0** . . . in., weight . . . . . lbs./ft. Wall thickness or gauge No. **sch. 40**

TYPE OF SCREEN OR PERFORATION MATERIAL:

1 Steel	3 Stainless steel	5 Fiberglass	7 PVC	10 Asbestos-cement
2 Brass	4 Galvanized steel	6 Concrete tile	8 RMP (SR)	11 Other (specify) .....
			9 ABS	12 None used (open hole)

SCREEN OR PERFORATION OPENINGS ARE:

1 Continuous slot	3 Mill slot	5 Gauzed wrapped	8 Saw cut	11 None (open hole)
2 Louvered shutter	4 Key punched	6 Wire wrapped	9 Drilled holes	
		7 Torch cut	10 Other (specify) .....	

SCREEN-PERFORATED INTERVALS:	From . . . . . 34.5 . . . ft. to . . . . . 19.5 . . . ft.,	From . . . . . . . . . ft. to . . . . . . . . . ft.
	From . . . . . . . . . ft. to . . . . . . . . . ft.,	From . . . . . . . . . ft. to . . . . . . . . . ft.
GRAVEL PACK INTERVALS:	From . . . . . 35 . . . ft. to . . . . . 18 . . . ft.,	From . . . . . . . . . ft. to . . . . . . . . . ft.
	From . . . . . . . . . ft. to . . . . . . . . . ft.,	From . . . . . . . . . ft. to . . . . . . . . . ft.

6 GROUT MATERIAL: 1 Neat cement 2 Cement grout 3 Bentonite 4 Other  
Grout Intervals: From 18 ft. to 16 ft. From 16 ft. to 0 ft. From ft. to ft.

What is the nearest source of possible contamination:

1 Septic tank	4 Lateral lines	7 Pit privy	10 Livestock pens	14 Abandoned water well
2 Sewer lines	5 Cess pool	8 Sewage lagoon	11 Fuel storage	15 Oil well/Gas well
3 Watertight sewer lines	6 Seepage pit	9 Feedyard	12 Fertilizer storage	16 Other (specify below)
			13 Insecticide storage	

Direction from well?	north	How many feet?	across Vine Street
----------------------	-------	----------------	--------------------

[illegible]

7 CONTRACTOR'S OR LANDOWNER'S CERTIFICATION: This water well was (1) constructed, (2) reconstructed, or (3) plugged under my jurisdiction and was completed on (mo/day/year) 10-13-93 and this record is true to the best of my knowledge and belief. Kansas Water Well Contractor's License No. 527 This Water Well Record was completed on (mo/day/yr) 12-01-93 under the business name of GeoCore Services, Inc. by (signature) Dale R. Bell