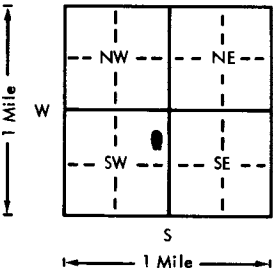
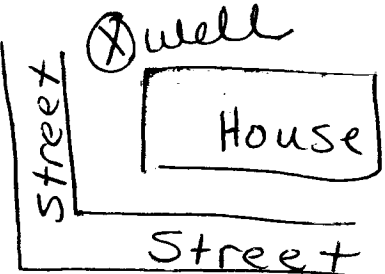


USE TYPEWRITER OR BALL POINT PEN-PRESS FIRMLY, PRINT CLEARLY.

WATER WELL RECORD  
KSA 82a-1201-1215

Kansas Department of Health and Environment-Division of Environment  
(Water well Contractors)  
Topeka, Kansas 66620

1. Location of well:	County <u>Ellis</u>	Fraction <u>NE 1/4 NE 1/4 SW 1/4</u>	Section number <u>34</u>	Township number <u>T 13</u>	Range number <u>R 18</u>	<u>EW</u>
2. Distance and direction from nearest town or city: Street address of well location if in city: <u>1319 E. 21st</u>			3. Owner of well: <u>Candy Ball</u> R.R. or street: <u>1319 E. 21st</u> City, state, zip code: <u>Hays, Kansas</u>			
<input checked="" type="checkbox"/> Locate with "X" in section below: 		Sketch map: 		6. Bore hole dia. <u>5</u> in. Completion date <u>5/17/76</u> Well depth <u>80</u> ft.		
				7. <input checked="" type="checkbox"/> Cable tool <input checked="" type="checkbox"/> Rotary <input type="checkbox"/> Driven <input type="checkbox"/> Dug <input type="checkbox"/> Hollow rod <input type="checkbox"/> Jetted <input type="checkbox"/> Bored <input type="checkbox"/> Reverse rotary		
				8. Use: <input type="checkbox"/> Domestic <input type="checkbox"/> Public supply <input type="checkbox"/> Industry <input type="checkbox"/> Irrigation <input type="checkbox"/> Air conditioning <input type="checkbox"/> Stock <input checked="" type="checkbox"/> Lawn <input type="checkbox"/> Oil field water <input type="checkbox"/> Other		
				<input checked="" type="checkbox"/> Casing: Material <u>PVC</u> Height: <u>Above</u> or below Threaded <input type="checkbox"/> Welded <input checked="" type="checkbox"/> Surface <u>1 1/2</u> in. RMP <input type="checkbox"/> PVC <input checked="" type="checkbox"/> Weight <u>12</u> lbs./ft. Dia. <u>5</u> in. to <u>80</u> ft. depth Wall Thickness: inches or Dia. <u>   </u> in. to <u>   </u> ft. depth gage No. <u>250</u>		
5. Type and color of material		From	To	10. Screen: Manufacturer's name <u>Jet Stream</u>		
<u>Fill dirt</u>		<u>0</u>	<u>3</u>	Type <u>PVC</u> Dia. <u>5"</u>		
<u>Topsoil</u>		<u>3</u>	<u>7</u>	<input checked="" type="checkbox"/> Slot/gauze Length <u>10'</u>		
<u>Subsoil</u>		<u>7</u>	<u>15</u>	Set between <u>25/68</u> ft. and <u>78</u> ft.		
<u>Brown Clay</u>		<u>15</u>	<u>55</u>	Gravel pack? <u>Yes</u> Size range of material <u>1/4"</u>		
<u>Fine sand to Gravel</u>		<u>55</u>	<u>75</u>	11. Static water level: <u>50</u> ft. below land surface Date <u>5/17/76</u>		
<u>Blue Shale</u>		<u>75</u>	<u>80</u>	12. Pumping level below land surfaces: <u>52</u> ft. after <u>1</u> hrs. pumping <u>10</u> g.p.m. <u>   </u> ft. after <u>   </u> hrs. pumping <u>   </u> g.p.m. Estimated maximum yield <u>10</u> g.p.m.		
				13. Water sample submitted: <u>   </u> mo./day/yr. <input type="checkbox"/> Yes <input checked="" type="checkbox"/> No Date <u>   </u>		
				14. Well head completion: <input checked="" type="checkbox"/> Pitless adapter <u>   </u> inches above grade		
				15. Well grouted? <u>Yes</u> With: <input type="checkbox"/> Neat cement <input type="checkbox"/> Bentonite <input checked="" type="checkbox"/> Concrete Depth: From <u>4</u> ft. to <u>12</u> ft.		
				16. Nearest source of possible contamination: <u>None</u> ft. <u>   </u> Direction <u>   </u> Type <u>   </u> Well disinfected upon completion? <input checked="" type="checkbox"/> Yes <input type="checkbox"/> No		
				17. Pump: <u>Not installed</u> Manufacturer's name <u>F&amp;W</u> Model number <u>SBA8</u> HP <u>1/2</u> Volts <u>220</u> Length of drop pipe <u>70</u> ft. capacity <u>10</u> g.p.m. Type: <input checked="" type="checkbox"/> Submersible <input type="checkbox"/> Turbine <input type="checkbox"/> Jet <input type="checkbox"/> Reciprocating <input type="checkbox"/> Centrifugal <input type="checkbox"/> Other		
		(Use a second sheet if needed)				
18. Elevation:		19. Remarks:		20. Water well contractor's certification: This well was drilled under my jurisdiction and this report is true to the best of my knowledge and belief. <u>Karst Waterwell</u> Business name <u>E. Hwy 40 Hays</u> License No. <u>   </u> Address <u>   </u> City <u>   </u> State <u>   </u> Zip <u>   </u> Signed <u>M. D. Karst</u> Date <u>5/17/76</u> Authorized representative		
Topography: <input checked="" type="checkbox"/> Hill <input type="checkbox"/> Slope <input type="checkbox"/> Upland <input type="checkbox"/> Valley		<u>None</u>				

T 13  
 R 18  
 E W  
 NE 1/4 NE 1/4 SW 1/4