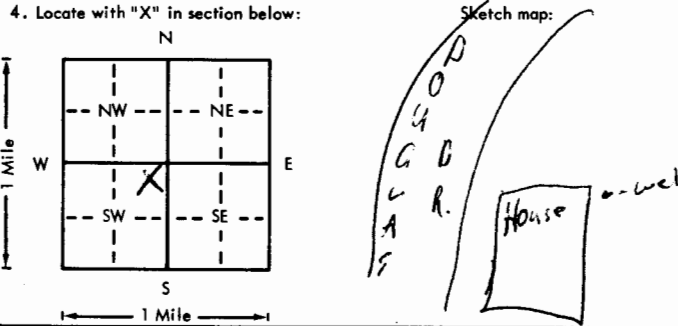


USE TYPEWRITER OR BALL POINT PEN-PRESS FIRMLY, PRINT CLEARLY.

WATER WELL RECORD  
KSA 82a-1201-1215

Kansas Department of Health and Environment-Division of Environment (Water well Contractors) Topeka, Kansas 66620

1. Location of well:		County <b>ELLIS</b>	Fraction <b>NE 1/4 NE 1/4 SW 1/4</b>	Section number <b>34</b>	Township number <b>T 13</b>	Range number <b>S R 18</b>																		
2. Distance and direction from nearest town or city: Street address of well location if in city: <b>SAME</b>				3. Owner of well: <b>Gene Kippes</b> R.R. or street: <b>1709 Douglas Dr.</b> City, state, zip code: <b>Hays, Kansas 67601</b>																				
4. Locate with "X" in section below: 				6. Bore hole dia. <b>9</b> in. Completion date <b>2/15/77</b> Well depth <b>65</b> ft.																				
5. Type and color of material				7. <input type="checkbox"/> Cable tool <input checked="" type="checkbox"/> Rotary <input type="checkbox"/> Driven <input type="checkbox"/> Dug <input type="checkbox"/> Hollow rod <input type="checkbox"/> Jetted <input type="checkbox"/> Bored <input type="checkbox"/> Reverse rotary																				
<table border="1" style="width:100%; border-collapse: collapse;"> <thead> <tr> <th style="width:80%;">Type and color of material</th> <th style="width:10%;">From</th> <th style="width:10%;">To</th> </tr> </thead> <tbody> <tr> <td>Top soil</td> <td>0</td> <td>4</td> </tr> <tr> <td>Brown clay</td> <td>4</td> <td>32</td> </tr> <tr> <td>Fine sand mixed with clay</td> <td>32</td> <td>45</td> </tr> <tr> <td>Coarse gravel</td> <td>45</td> <td>63</td> </tr> <tr> <td>Shale</td> <td>63</td> <td>65</td> </tr> </tbody> </table>				Type and color of material	From	To	Top soil	0	4	Brown clay	4	32	Fine sand mixed with clay	32	45	Coarse gravel	45	63	Shale	63	65	8. Use: <input type="checkbox"/> Domestic <input type="checkbox"/> Public supply <input type="checkbox"/> Industry <input checked="" type="checkbox"/> Irrigation <input type="checkbox"/> Air conditioning <input type="checkbox"/> Stock <input checked="" type="checkbox"/> Lawn <input type="checkbox"/> Oil field water <input type="checkbox"/> Other		
Type and color of material	From	To																						
Top soil	0	4																						
Brown clay	4	32																						
Fine sand mixed with clay	32	45																						
Coarse gravel	45	63																						
Shale	63	65																						
				9. Casing: Material _____ Height: <b>Above</b> or below Threaded _____ Welded <b>gl</b> Surface <b>16</b> in. RMP _____ PVC <b>gl</b> Weight _____ lbs./ft. Dia. <b>5</b> in. to <b>65</b> ft. depth Wall Thickness: inches or Dia. _____ in. to _____ ft. depth Gage No. <b>160</b>																				
				10. Screen: Manufacturer's name <b>Jet stream</b> Type <b>PVC</b> Dia. <b>5"</b> Sole <b>1031</b> Length <b>10</b> Set between <b>65</b> ft. and <b>65</b> ft. _____ ft. and _____ ft. Gravel pack? <b>YES</b> Size range of material <b>18-1/4</b>																				
				11. Static water level: _____ mo./day/yr. <b>35</b> ft. below land surface Date <b>2/15/77</b>																				
				12. Pumping level below land surfaces: <b>39</b> ft. after <b>1</b> hrs. pumping <b>10</b> g.p.m. _____ ft. after _____ hrs. pumping _____ g.p.m. Estimated maximum yield <b>10</b> g.p.m.																				
				13. Water sample submitted: _____ mo./day/yr. <input type="checkbox"/> Yes <input checked="" type="checkbox"/> No Date _____																				
				14. Well head completion: <input type="checkbox"/> Pitless adapter <b>16</b> Inches above grade																				
				15. Well grouted? <b>YES</b> With: <input type="checkbox"/> Neat cement <input type="checkbox"/> Bentonite <input checked="" type="checkbox"/> Concrete Depth: From <b>10P</b> ft. to <b>10</b> ft.																				
				16. Nearest source of possible contamination: <b>NONE</b> ft. _____ Direction _____ Type _____ Well disinfected upon completion? <input checked="" type="checkbox"/> Yes <input type="checkbox"/> No																				
				17. Pump: _____ Not installed Manufacturer's name <b>F&amp;W</b> Model number <b>5B88</b> HP <b>1/2</b> Volts <b>230</b> Length of drop pipe <b>60</b> ft. capacity <b>10</b> g.p.m. Type: <input checked="" type="checkbox"/> Submersible <input type="checkbox"/> Turbine <input type="checkbox"/> Jet <input type="checkbox"/> Reciprocating <input type="checkbox"/> Centrifugal <input type="checkbox"/> Other																				
(Use a second sheet if needed)																								
18. Elevation:		19. Remarks:		20. Water well contractor's certification: This well was drilled under my jurisdiction and this report is true to the best of my knowledge and belief. <b>KARST WATER WELL PRIC</b> Business name _____ License No. _____ Address <b>HICUM 40</b> _____ 199A Signed <b>EMB Kent</b> _____ Date <b>2-15-77</b> Authorized representative																				
Topography: <input type="checkbox"/> Hill <input type="checkbox"/> Slope <input checked="" type="checkbox"/> Upland <input type="checkbox"/> Valley																								

T 13 R 18 S 18 NE 1/4 34 NE 1/4 SW 1/4

Forward the white, blue and pink copies to the Department of Health and Environment

Form WWC-5