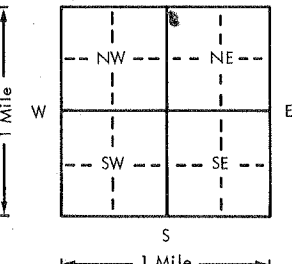
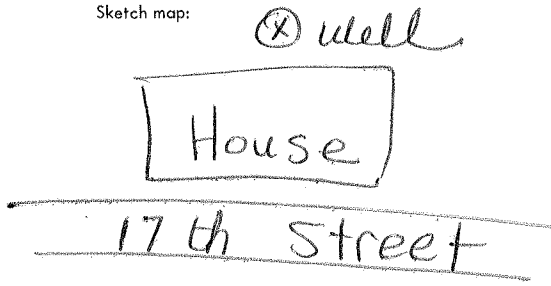


USE TYPEWRITER OR BALL POINT PEN-PRESS FIRMLY, PRINT CLEARLY.

WATER WELL RECORD
KSA 82a-1201-1215

Kansas Department of Health and Environment-Division of Environment (Water well Contractors) Topeka, Kansas 66620

1. Location of well:		County Ellis	Fraction NW 1/4 NW 1/4 NE 1/4	Section number 34	Township number T 13 S R 18 E/W (1)	Range number
2. Distance and direction from nearest town or city: Street address of well location if in city: 1009 E. 17th				3. Owner of well: Jerry Penka R.R. or street: 1304 Steven Drive City, state, zip code: Hays, Kansas 67601		
X Locate with "X" in section below: 		Sketch map: 		6. Bore hole dia. 9 in. Completion date 4/13/76 Well depth 63 ft.		
5. Type and color of material		From	To	7. Cable tool <input checked="" type="checkbox"/> Rotary <input type="checkbox"/> Driven <input type="checkbox"/> Dug <input type="checkbox"/> Hollow rod <input type="checkbox"/> Jetted <input type="checkbox"/> Bored <input type="checkbox"/> Reverse rotary		
Topsoil		0	4	8. Use: <input type="checkbox"/> Domestic <input type="checkbox"/> Public supply <input type="checkbox"/> Industry <input checked="" type="checkbox"/> Irrigation <input type="checkbox"/> Air conditioning <input type="checkbox"/> Stock <input checked="" type="checkbox"/> Lawn <input type="checkbox"/> Oil field water <input type="checkbox"/> Other		
Subsoil		4	11	X Casing: Material PVC Height Above or below Threaded <input type="checkbox"/> Welded <input checked="" type="checkbox"/> Surface 12 in. RMP <input type="checkbox"/> PVC <input checked="" type="checkbox"/> Weight <input type="checkbox"/> lbs./ft. Dia. 5 in. to 63 ft. depth, Wall Thickness: inches or Dia. <input type="checkbox"/> in. to <input type="checkbox"/> ft. depth gage No. <input type="checkbox"/>		
Yellow Clay		11	21	10. Screen: Manufacturer's name jet stream Type PVC Dia. 5" Slope gauze <input type="checkbox"/> Length 10' Set between 52 ft. and 62 ft. Gravel pack? Yes Size range of material 1/4"		
Brown Clay		21	42	11. Static water level: <input type="checkbox"/> mo./day/yr. 40 ft. below land surface Date 4/13/76		
Fine to Medium Sand		42	59	12. Pumping level below land surfaces: 40 ft. after 1 hrs. pumping 10 g.p.m. _____ ft. after _____ hrs. pumping _____ g.p.m. Estimated maximum yield 10 g.p.m.		
Blue Shale		59	63	13. Water sample submitted: <input type="checkbox"/> Yes <input checked="" type="checkbox"/> No Date _____		
(Use a second sheet if needed)				14. Well head completion: <input type="checkbox"/> Pitless adapter 12 Inches above grade		
				X Well grouted? Yes With: <input type="checkbox"/> Neat cement <input type="checkbox"/> Bentonite <input checked="" type="checkbox"/> Concrete Depth: From 2 ft. to 9 ft.		
				16. Nearest source of possible contamination: None ft. _____ Direction _____ Type _____ Well disinfected upon completion? <input checked="" type="checkbox"/> Yes <input type="checkbox"/> No		
				17. Pump: <input checked="" type="checkbox"/> Not installed Manufacturer's name _____ Model number _____ HP _____ Volts _____ Length of drop pipe _____ ft. capacity _____ g.p.m. Type: <input type="checkbox"/> Submersible <input type="checkbox"/> Turbine <input type="checkbox"/> Jet <input type="checkbox"/> Reciprocating <input type="checkbox"/> Centrifugal <input type="checkbox"/> Other		
18. Elevation:	19. Remarks:		X 20. Water well contractor's certification: This well was drilled under my jurisdiction and this report is true to the best of my knowledge and belief. Karst Water Well 1991B Business name _____ License No. _____ Address E. Hwy 40 Hays, Ka Signed EM B Karst Date 4/13/76 Authorized representative			
Topography: <input type="checkbox"/> Hill <input type="checkbox"/> Slope <input checked="" type="checkbox"/> Upland <input type="checkbox"/> Valley	None					

Forward the white, blue and pink copies to the Department of Health and Environment

Form WWC-5