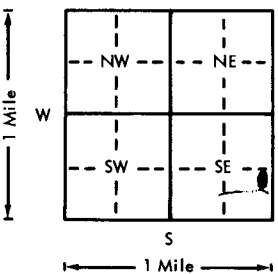
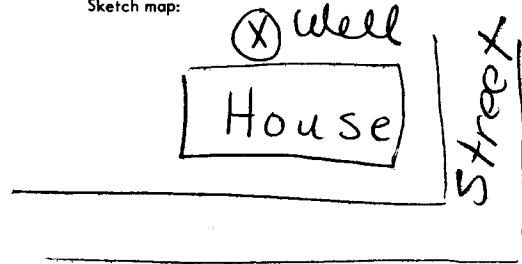


USE TYPEWRITER OR BALL POINT PEN-PRESS FIRMLY, PRINT CLEARLY.

WATER WELL RECORD
KSA 82a-1201-1215

Kansas Department of Health and Environment-Division of Environment
(Water well Contractors)
Topeka, Kansas 66620

1. Location of well:	County Ellis	Fraction NE 1/4 SE 1/4 SE 1/4	Section number 34	Township number T 13 S	Range number R 18 E
2. Distance and direction from nearest town or city: Street address of well location if in city: 1211 Felten			3. Owner of well: Dale Bieker R.R. or street: 1211 Felten City, state, zip code: Hays, Kansas 67601		
X Locate with "X" in section below: 		Sketch map: 		6. Bore hole dia. 9 in. Completion date 4/20/76 Well depth 40 ft.	
5. Type and color of material		From	To	7. Cable tool <input checked="" type="checkbox"/> Rotary <input type="checkbox"/> Driven <input type="checkbox"/> Dug <input type="checkbox"/> Hollow rod <input type="checkbox"/> Jetted <input type="checkbox"/> Bored <input type="checkbox"/> Reverse rotary	
Topsoil Brown Clay Medium Sand Blue Shale		0	5	8. Use: <input type="checkbox"/> Domestic <input type="checkbox"/> Public supply <input type="checkbox"/> Industry <input type="checkbox"/> Irrigation <input type="checkbox"/> Air conditioning <input type="checkbox"/> Stock <input checked="" type="checkbox"/> Lawn <input type="checkbox"/> Oil field water <input type="checkbox"/> Other	
				X Casing: Material PVC Height: Above or below Threaded <input type="checkbox"/> Welded <input checked="" type="checkbox"/> Surface 93 in. RMP <input type="checkbox"/> PVC <input checked="" type="checkbox"/> Weight _____ lbs./ft. Dia. 5 in. to 40 ft. depth, Wall Thickness: inches or Dia. _____ in. to _____ ft. depth, gage No. 255	
				10. Screen: Manufacturer's name Jet Stream Type PVC Dia. 5" Slot/gauze _____ Length 10' Set between 28 ft. and 38 ft. _____ ft. and _____ ft. Gravel pack? <input checked="" type="checkbox"/> Yes Size range of material 1/4"	
				11. Static water level: _____ mo./day/yr. 25 ft. below land surface Date 4/20/76	
				12. Pumping level below land surfaces: 25 ft. after 1 hrs. pumping 10 g.p.m. _____ ft. after _____ hrs. pumping _____ g.p.m. Estimated maximum yield _____ g.p.m.	
				13. Water sample submitted: _____ mo./day/yr. Yes <input checked="" type="checkbox"/> No <input type="checkbox"/> Date _____	
				14. Well head completion: _____ Pitless adapter _____ 13 Inches above grade	
				X Well grouted? <input checked="" type="checkbox"/> Yes With: _____ Neat cement _____ Bentonite <input checked="" type="checkbox"/> Concrete Depth: From 2 ft. to 10 ft.	
				16. Nearest source of possible contamination: None ft. _____ Direction _____ Type _____ Well disinfected upon completion? <input checked="" type="checkbox"/> Yes <input type="checkbox"/> No	
				17. Pump: _____ Not installed Manufacturer's name Red Jacket Model number BUC501 HP 1/2 Volts 220 Length of drop pipe 35 ft. capacity 10 g.p.m. Type: <input checked="" type="checkbox"/> Submersible <input type="checkbox"/> Turbine <input type="checkbox"/> Jet <input type="checkbox"/> Reciprocating <input type="checkbox"/> Centrifugal <input type="checkbox"/> Other	
				X Water well contractor's certification: This well was drilled under my jurisdiction and this report is true to the best of my knowledge and belief. Karst Water Well 199A Business name _____ License No. _____ Address E. Hwy 40 Hays, Ka. Signed Ch B. Bieker Date 4/20/76 Authorized representative	
18. Elevation:	19. Remarks:				
Topography: <input checked="" type="checkbox"/> Hill <input type="checkbox"/> Slope <input type="checkbox"/> Upland <input type="checkbox"/> Valley	None				

Forward the white, blue and pink copies to the Department of Health and Environment

Form WWC-5