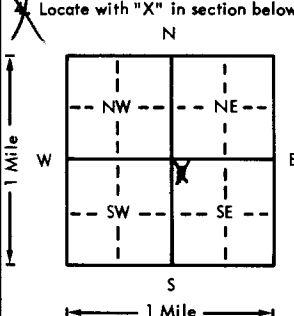
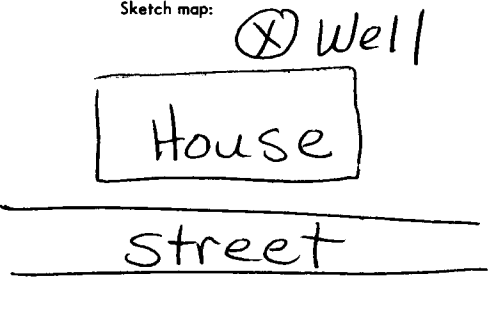


USE TYPEWRITER OR BALL POINT PEN—PRESS FIRMLY, PRINT CLEARLY.

WATER WELL RECORD
KSA 82a-1201-1215

Kansas Department of Health and Environment—Division of Environment
(Water well Contractors)
Topeka, Kansas 66620

1. Location of well:	County Ellis	Fraction NW 1/4 NW 1/4 SE 1/4	Section number 34	Township number T 13 S R 18 E/W 1	Range number
2. Distance and direction from nearest town or city: Street address of well location if in city: 1313 Donald			3. Owner of well: Alan Wolf R.R. or street: 1313 Donald City, state, zip code: Hays, Kansas 67601		
<input checked="" type="checkbox"/> Locate with "X" in section below: 			Sketch map: 		
5. Type and color of material			From	To	6. Bore hole dia. <u>5</u> in. Completion date 6/4/75 Well depth 59 ft. 7. <input checked="" type="checkbox"/> Cable tool <input checked="" type="checkbox"/> Rotary <input type="checkbox"/> Driven <input type="checkbox"/> Dug <input type="checkbox"/> Hollow rod <input type="checkbox"/> Jetted <input type="checkbox"/> Bored <input type="checkbox"/> Reverse rotary 8. Use: <input type="checkbox"/> Domestic <input type="checkbox"/> Public supply <input type="checkbox"/> Industry <input checked="" type="checkbox"/> Irrigation <input type="checkbox"/> Air conditioning <input type="checkbox"/> Stock <input checked="" type="checkbox"/> Lawn <input type="checkbox"/> Oil field water <input type="checkbox"/> Other <input checked="" type="checkbox"/> Casing: Material PVC Height: Above or below Threaded <input type="checkbox"/> Welded <input checked="" type="checkbox"/> Surface 20 in. RMP <input type="checkbox"/> PVC <input checked="" type="checkbox"/> Weight <input type="checkbox"/> lbs./ft. Dia. 5 in. to 59 ft. depth Wall Thickness: inches or Dia. <input type="checkbox"/> in. to <input type="checkbox"/> ft. depth Gage No. e258
Topsoil			0	4	10. Screen: Manufacturer's name Jet Stream
Subsoil			4	12	Type PVC Dia. 5"
Brown Clay			12	30	Slot/gauze <input checked="" type="checkbox"/> Length 10'
Brown Clay w Fine Sand			30	42	Set between 58 ft. and 68 ft.
Medium Sand			42	55	Grovel pack? <input checked="" type="checkbox"/> Yes Size range of material 1/4"
Blue Shale			55	59	11. Static water level: <u>46</u> ft. below land surface Date 6/4/75
					12. Pumping level below land surfaces: <u>42</u> ft. after <u>1</u> hrs. pumping <u>10</u> g.p.m. ___ ft. after ___ hrs. pumping ___ g.p.m. Estimated maximum yield <u>10</u> g.p.m.
					13. Water sample submitted: ___ mo./day/yr. Yes <input checked="" type="checkbox"/> No <input type="checkbox"/> Date ___
					14. Well head completion: ___ Pitless adapter <u>20</u> Inches above grade
					<input checked="" type="checkbox"/> Well grouted? <input checked="" type="checkbox"/> Yes With: ___ Neat cement ___ Bentonite <input checked="" type="checkbox"/> Concrete Depth: From <u>1</u> ft. to <u>9</u> ft.
					16. Nearest source of possible contamination: None ft. ___ Direction ___ Type ___ Well disinfected upon completion? <input checked="" type="checkbox"/> Yes ___ No
					17. Pump: <input checked="" type="checkbox"/> Not installed Manufacturer's name ___ Model number ___ HP ___ Volts ___ Length of drop pipe ___ ft. capacity ___ g.p.m. Type: ___ Submersible ___ Turbine ___ Jet ___ Reciprocating ___ Centrifugal ___ Other
					18. Elevation:
					19. Remarks: None
					20. Water well contractor's certification: This well was drilled under my jurisdiction and this report is true to the best of my knowledge and belief. Karst Water Well 199A Business name E Hwy 40 Hays License No. ___ Address 1313 Donald Signed [Signature] Date 6/4/75 Authorized representative

Forward the white, blue and pink copies to the Department of Health and Environment

Form WWC-5