

LOCATION OF WATER WELL: Fraction *nw 1/4 nw 1/4 ne 1/4* Section Number *34* Township Number *T 13 S* Range Number *R 18 EW*
 County: *Ellis* Distance and direction from nearest town or city? *in Hays* Street address of well if located within city? *2310 New Custer*

WATER WELL OWNER: *Ron Wentz*
 R#, St. Address, Box #: *2310 New Custer, Hays, Ks. 67601* Board of Agriculture, Division of Water Resources
 City, State, ZIP Code: *2310 New Custer, Hays, Ks. 67601* Application Number:


DEPTH OF COMPLETED WELL: *46* ft. Bore Hole Diameter: *10* in. to ft., and in. to ft.
 Well Water to be used as:
 1 Domestic 3 Feedlot 5 Public water supply 8 Air conditioning 11 Injection well
 2 Irrigation 4 Industrial 6 Oil field water supply 9 Dewatering 12 Other (Specify below)
 7 Lawn and garden only 10 Observation well
 Well's static water level: *17* ft. below land surface measured on *Aug.* month *22* day *1980* year
 Pump Test Data: Well water was ft. after hours pumping. gpm
 Static Yield *15* gpm: Well water was *25* ft. after *30 min.* hours pumping *barling* gpm

TYPE OF BLANK CASING USED:
 1 Steel 3 RMP (SR) 5 Wrought iron 8 Concrete tile Casing Joints: Glued Clamped
 2 PVC 4 ABS 6 Asbestos-Cement 9 Other (specify below) Welded
 7 Fiberglass *styrene 200* Threaded
 Blank casing dia: *5* in. to *26* ft., Dia: in. to ft., Dia: in. to ft.
 Casing height above land surface: *20* in., weight lbs./ft. Wall thickness or gauge No. *14 in.*

TYPE OF SCREEN OR PERFORATION MATERIAL:
 1 Steel 3 Stainless steel 5 Fiberglass 8 RMP (SR) 10 Asbestos-cement 11 Other (specify) *styrene*
 2 Brass 4 Galvanized steel 6 Concrete tile 9 ABS 12 None used (open hole)
 Screen or Perforation Openings Are:
 1 Continuous slot 3 Mill slot 5 Gauzed wrapped 8 Saw cut 11 None (open hole)
 2 Louvered shutter 4 Key punched 6 Wire wrapped 9 Drilled holes
 7 Torch cut 10 Other (specify)
 Screen-Perforation Dia: *5* in. to ft., Dia: in. to ft., Dia: in. to ft.
 Screen-Perforated Intervals: From *26* ft. to *46* ft., From ft. to ft. to ft. to ft.
 Gravel Pack Intervals: From *24* ft. to *46* ft., From ft. to ft. to ft. to ft.

GROUT MATERIAL: 1 Neat cement 2 Cement grout 3 Bentonite 4 Other
 Grouted Intervals: From *6* ft. to *16* ft., From ft. to ft., From ft. to ft. to ft.
 What is the nearest source of possible contamination:
 1 Septic tank 4 Cess pool 7 Sewage lagoon 11 Fertilizer storage 14 Abandoned water well
2 Sewer lines 5 Seepage pit 8 Feed yard 12 Insecticide storage 15 Oil well/Gas well
 3 Lateral lines 6 Pit privy 9 Livestock pens 13 Watertight sewer lines 16 Other (specify below)
 Direction from well: *north* How many feet: *25* ? Water Well Disinfected? Yes No
 Has a chemical/bacteriological sample submitted to Department? Yes No If yes, date sample
 as submitted month day year: Pump Installed? Yes No
 Yes: Pump Manufacturer's name Model No. HP Volts
 Depth of Pump Intake ft. Pumps Capacity rated at gal./min.
 Type of pump: 1 Submersible 2 Turbine 3 Jet 4 Centrifugal 5 Reciprocating 6 Other

CONTRACTOR'S OR LANDOWNER'S CERTIFICATION: This water well was 1 constructed, (2) reconstructed, or (3) plugged under my jurisdiction and was
 completed on *8* month *22* day *1980* year
 I certify this record is true to the best of my knowledge and belief. Kansas Water Well Contractor's License No. *276*
 This Water Well Record was completed on *8* month *22* day *1980* year under the business
 name of *Linea Water Well Drly* by (signature) *John Linea*

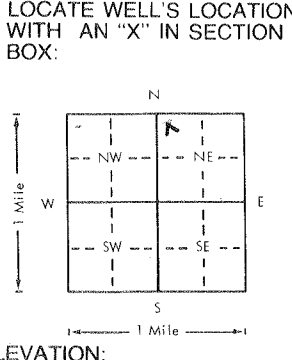

FROM	TO	LITHOLOGIC LOG	FROM	TO	LITHOLOGIC LOG
0	2	Top soil			
2	17	Brown Clay			
17	21	7' Gray sand w/ B. Clay			
21	35	Coarse H. sand w/ B. Clay			
35	45	coarse H. sand w/ small white gravel			
45	46	dark Blue shale			

DEPTH(S) Groundwater Encountered 1. ft. 2. ft. 3. ft. 4. ft. (Use a second sheet if needed)

INSTRUCTIONS: Use typewriter or ball point pen, please press firmly and PRINT clearly. Please fill in blanks, underline or circle the correct answers. Send top three copies to Kansas Department of Health and Environment, Division of Environment, Water Well Contractors, Topeka, KS 66620. Send one to WATER WELL OWNER and retain one for your records.