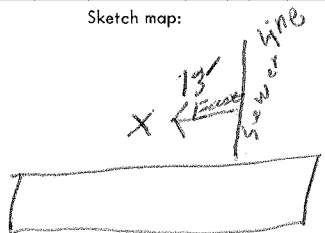


USE TYPEWRITER OR BALL POINT PEN-PRESS FIRMLY, PRINT CLEARLY.

WATER WELL RECORD
KSA 82a-1201-1215

Kansas Department of Health and Environment-Division of Environment
(Water well Contractors)
Topeka, Kansas 66620

1. Location of well:		County Ellis	Fraction Se 1/4 NW 1/4 NW 1/4	Section number 34	Township number T 13 S R 18	Range number 18	EXW			
2. Distance and direction from nearest town or city: Street address of well location if in city: 1115 Centennial			3. Owner of well: Robert Scheck R.R. or street: 1115 Centennial City, state, zip code: Hays, Kansas 67601							
4. Locate with "X" in section below: N W E S 1 Mile 1 Mile			Sketch map: 		6. Bore hole dia. 6 in. Completion date _____ Well depth 42 ft. 5-15-75					
5. Type and color of material			From	To	7. Cable tool <input checked="" type="checkbox"/> Rotary <input type="checkbox"/> Driven <input type="checkbox"/> Dug <input type="checkbox"/> Hollow rod <input type="checkbox"/> Jetted <input checked="" type="checkbox"/> Bored <input type="checkbox"/> Reverse rotary					
			Topsoil BLACK			0	5	8. Use: <input type="checkbox"/> Domestic <input type="checkbox"/> Public supply <input type="checkbox"/> Industry <input type="checkbox"/> Irrigation <input type="checkbox"/> Air conditioning <input type="checkbox"/> Stock <input checked="" type="checkbox"/> Lawn <input type="checkbox"/> Oil field water <input type="checkbox"/> Other		
			Clay			5	25	9. Casing: Material Plst Height: Above br below Threaded <input type="checkbox"/> Welded g1 Surface 12 in. RMP <input checked="" type="checkbox"/> PVC <input type="checkbox"/> Weight _____ lbs./ft. Dia. 5 in. to 42 ft. depth Wall Thickness: inches or Dia. _____ in. to _____ ft. depth gage No. 0.258		
			Sand, fine, brown			25	37	10. Screen: Manufacturer's name _____ Jess & Lowell Type RMP Dia. 5 1/4 Slot/gauze 06 (1/16) Length 10 ft Set between 32 ft. and 42 ft. _____ ft. and _____ ft. Gravel pack? <input checked="" type="checkbox"/> yes Size range of material 1/2"		
			Sand, coarse brown			37	42	11. Static water level: _____ mo./day/yr. 32 ft. below land surface Date 5-15-75		
Blue Shale			42		12. Pumping level below land surfaces: 36 ft. after 1 hrs. pumping 18 g.p.m. _____ ft. after _____ hrs. pumping _____ g.p.m. Estimated maximum yield 18 g.p.m.					
					13. Water sample submitted: _____ mo./day/yr. Yes <input type="checkbox"/> No <input checked="" type="checkbox"/> Date _____					
					14. Well head completion: <input type="checkbox"/> Pitless adapter 12 Inches above grade					
					15. Well grouted? <input checked="" type="checkbox"/> yes With: <input checked="" type="checkbox"/> Neat cement <input type="checkbox"/> Bentonite <input type="checkbox"/> Concrete Depth: From 0 ft. to 10 ft.					
					16. Nearest source of possible contamination: ft. 13 Direction E Type Sewer Well disinfected upon completion? <input checked="" type="checkbox"/> Yes <input type="checkbox"/> No					
					17. Pump: _____ Not installed Manufacturer's name Fairbanks Morse Model number _____ HP 1/2 Volts 220 Length of drop pipe 40 ft. capacity 20 g.p.m. Type: <input checked="" type="checkbox"/> Submersible <input type="checkbox"/> Turbine <input type="checkbox"/> Jet <input type="checkbox"/> Reciprocating <input type="checkbox"/> Centrifugal <input type="checkbox"/> Other					
					(Use a second sheet if needed)					
18. Elevation:		19. Remarks:		20. Water well contractor's certification: This well was drilled under my jurisdiction and this report is true to the best of my knowledge and belief. R. F. Coupald 266 Business name License No. Address 616 E. 6th Hays, Ks 67601 Signed Raymond Coupald Date 5-16-75 Authorized representative						
Topography: <input type="checkbox"/> Level <input type="checkbox"/> Hill <input type="checkbox"/> Slope <input type="checkbox"/> Upland <input type="checkbox"/> Valley										

T 13 S R 18
Sec 34
1/4 1/4 1/4

Forward the white, blue and pink copies to the Department of Health and Environment

Form WWC-5