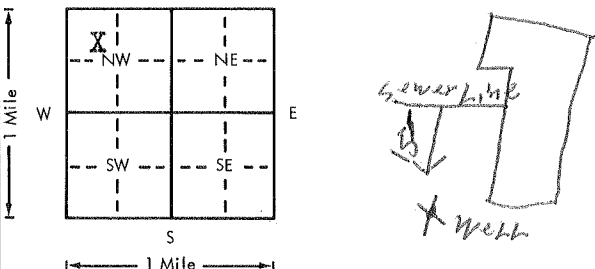


USE TYPEWRITER OR BALL POINT PEN-PRESS FIRMLY, PRINT CLEARLY.

WATER WELL RECORD
KSA 82a-1201-1215

Kansas Department of Health and Environment-Division of Environment (Water well Contractors) Topeka, Kansas 66620

1. Location of well:	County Ellis	Fraction SE 1/4 NW 1/4 NW 1/4	Section number 34	Township number T 13 S R 18	Range number E/W
2. Distance and direction from nearest town or city: Street address of well location if in city: 2509 General Lawton			3. Owner of well: Albert Boucher R.R. or street: 2509 General Lawton Rd. City, state, zip code: Hays, Kansas 67601		
4. Locate with "X" in section below: N W E S 1 Mile Sketch map: 			6. Bore hole dia. <u>6</u> in. Completion date _____ Well depth <u>43</u> ft. <u>5-25-75</u>		
5. Type and color of material			7. <input type="checkbox"/> Cable tool <input checked="" type="checkbox"/> Rotary <input type="checkbox"/> Driven <input type="checkbox"/> Dug <input type="checkbox"/> Hollow rod <input type="checkbox"/> Jetted <input checked="" type="checkbox"/> Bored <input type="checkbox"/> Reverse rotary		
			8. Use: <input type="checkbox"/> Domestic <input type="checkbox"/> Public supply <input type="checkbox"/> Industry <input type="checkbox"/> Irrigation <input type="checkbox"/> Air conditioning <input type="checkbox"/> Stock <input checked="" type="checkbox"/> Lawn <input type="checkbox"/> Oil field water <input type="checkbox"/> Other		
			9. Casing: Material <u>plst</u> Height: Above or below Threaded _____ Welded <u>gl</u> Surface <u>12</u> in. RMP <input checked="" type="checkbox"/> PVC _____ Weight _____ lbs./ft. Dia. <u>5</u> in. to <u>43</u> ft. depth Wall thickness: inches or Dia. _____ in. to _____ ft. depth gage No. <u>258</u>		
			10. Screen: Manufacturer's name <u>Jess & Lowell</u> Type <u>RMP</u> Dia. <u>5</u> Slot/gauze <u>06(1/16)</u> Length <u>8</u> ft Set between <u>35</u> ft. and <u>43</u> ft. _____ ft. and _____ ft. Gravel pack? <u>yes</u> Size range of material <u>1/8"</u>		
			11. Static water level: <u>33</u> ft. below land surface Date <u>5-25-75</u> mo./day/yr.		
			12. Pumping level below land surfaces: <u>35</u> ft. after <u>1</u> hrs. pumping <u>18</u> g.p.m. _____ ft. after _____ hrs. pumping _____ g.p.m. Estimated maximum yield <u>21</u> g.p.m.		
			13. Water sample submitted: _____ mo./day/yr. Yes <input type="checkbox"/> No <input checked="" type="checkbox"/> Date _____		
			14. Well head completion: <input type="checkbox"/> Pitless adapter <u>12</u> Inches above grade		
			15. Well grouted? <u>yes</u> With: <input checked="" type="checkbox"/> Neat cement _____ Bentonite _____ Concrete _____ Depth: From <u>0</u> ft. to <u>10</u> ft.		
			16. Nearest source of possible contamination: ft. <u>15</u> Direction <u>N</u> Type <u>Sewer line</u> Well disinfected upon completion? <input checked="" type="checkbox"/> Yes _____ No		
			17. Pump: _____ Not installed Manufacturer's name <u>Fairbanks Morse</u> Model number _____ HP <u>1/2</u> Volts <u>220</u> Length of drop pipe <u>41</u> ft. capacity <u>15</u> g.p.m. Type: <input checked="" type="checkbox"/> Submersible _____ Turbine <input type="checkbox"/> Jet _____ Reciprocating <input type="checkbox"/> Centrifugal _____ Other		
			(Use a second sheet if needed)		
18. Elevation:		19. Remarks:			
Topography: <input type="checkbox"/> Hill <u>Level</u> <input type="checkbox"/> Slope <input type="checkbox"/> Upland <input type="checkbox"/> Valley					
		20. Water well contractor's certification: This well was drilled under my jurisdiction and this report is true to the best of my knowledge and belief. R. F. Coupal 266 Business name License No. Address <u>616 E. 6th Hays, Ks</u> Signed <u>Raymond F. Coupal</u> Date <u>5-25-75</u> Authorized representative			

T 13 R 18 SE 34 NW 1/4 1/4 1/4

Forward the white, blue and pink copies to the Department of Health and Environment

Form WWC-5