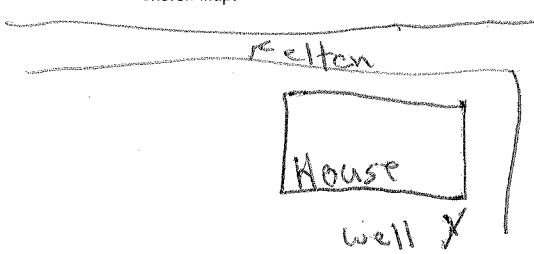


USE TYPEWRITER OR BALL POINT PEN-PRESS FIRMLY, PRINT CLEARLY.

WATER WELL RECORD
KSA 82a-1201-1215

Kansas Department of Health and Environment-Division of Environment (Water well Contractors) Topeka, Kansas 66620

1. Location of well:	County: <u>Ellis</u>	Fraction: <u>SE 1/4 SE 1/4 NW 1/4</u>	Section number: <u>34</u>	Township number: <u>T 13 S R 18 E</u>	Range number: <u>18 E</u>
2. Distance and direction from nearest town or city: Street address of well location if in city: <u>1709 Felten</u>			3. Owner of well: <u>Marvik Befort</u> R.R. or street: <u>1709 Felten</u> City, state, zip code: <u>Hays KS</u>		
4. Locate with "X" in section below: N W E S 1 Mile 1 Mile			Sketch map: 		
5. Type and color of material			6. Bore hole dia. <u>9</u> in. Completion date <u>6-24-76</u> Well depth <u>40</u> ft.		
			7. <input type="checkbox"/> Cable tool <input checked="" type="checkbox"/> Rotary <input type="checkbox"/> Driven <input type="checkbox"/> Dug <input type="checkbox"/> Hollow rod <input type="checkbox"/> Jetted <input type="checkbox"/> Bored <input type="checkbox"/> Reverse rotary		
			8. Use: <input type="checkbox"/> Domestic <input type="checkbox"/> Public supply <input type="checkbox"/> Industry <input type="checkbox"/> Irrigation <input type="checkbox"/> Air conditioning <input type="checkbox"/> Stock <input checked="" type="checkbox"/> Lawn <input type="checkbox"/> Oil field water <input type="checkbox"/> Other		
			9. Casing: Material <u>PVC</u> Height: <u>Above</u> or below Threading: <input type="checkbox"/> Welded <input checked="" type="checkbox"/> Surface <u>15</u> in. RMP: <input type="checkbox"/> PVC <input checked="" type="checkbox"/> Weight <u>2.8</u> lbs./ft. Dia. <u>5</u> in. to <u>40</u> ft. depth Wall Thickness: inches or Dia. <u>5</u> in. to <u>40</u> ft. depth gage No. <u>228</u>		
			10. Screen: Manufacturer's name <u>Jet stream</u> Type <u>PVC</u> Dia. <u>5"</u> Slot/gauze Length <u>10'</u> Set between <u>29</u> ft. and <u>39</u> ft. Gravel pack? <input checked="" type="checkbox"/> Yes Size range of material <u>1/4"</u>		
			11. Static water level: <u>30</u> ft. below land surface Date <u>6/24/76</u> mo./day/yr.		
			12. Pumping level below land surfaces: <u>30</u> ft. after <u>1</u> hrs. pumping <u>25</u> g.p.m. ____ ft. after ____ hrs. pumping ____ g.p.m. Estimated maximum yield <u>25</u> g.p.m.		
			13. Water sample submitted: ____ Yes <input checked="" type="checkbox"/> No Date ____ mo./day/yr.		
			14. Well head completion: <u>15</u> Pitless adapter ____ Inches above grade		
			15. Well grouted? <input checked="" type="checkbox"/> Yes With: <input type="checkbox"/> Neat cement <input type="checkbox"/> Bentonite <input checked="" type="checkbox"/> Concrete Depth: From <u>1</u> ft. to <u>9</u> ft.		
			16. Nearest source of possible contamination: <u>None</u> ft. ____ Direction ____ Type ____ Well disinfected upon completion? <input checked="" type="checkbox"/> Yes <input type="checkbox"/> No		
			17. Pump: <input checked="" type="checkbox"/> Not installed Manufacturer's name <u>F&W</u> Model number <u>5BA8</u> HP <u>1/2</u> Volts <u>220</u> Length of drop pipe <u>35</u> ft. capacity <u>10</u> g.p.m. Type: <input checked="" type="checkbox"/> Submersible <input type="checkbox"/> Turbine <input type="checkbox"/> Jet <input type="checkbox"/> Reciprocating <input type="checkbox"/> Centrifugal <input type="checkbox"/> Other		
18. Elevation:			19. Remarks:		
Topography: <input type="checkbox"/> Hill <input checked="" type="checkbox"/> Slope <input checked="" type="checkbox"/> Upland <input type="checkbox"/> Valley			<u>None</u>		
			20. Water well contractor's certification: This well was drilled under my jurisdiction and this report is true to the best of my knowledge and belief. <u>Karst Water Well 199A</u> Business name License No. ____ Address <u>E Hwy 40 Hays</u> Signed <u>CM B Karst</u> Date <u>6/24/76</u> Authorized representative		

Forward the white, blue and pink copies to the Department of Health and Environment

Form WWC-5