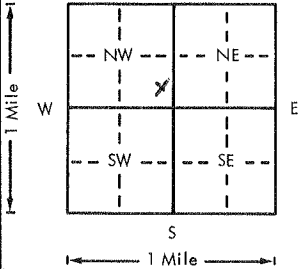
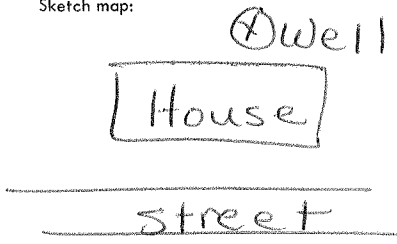


USE TYPEWRITER OR BALL POINT PEN-PRESS FIRMLY, PRINT CLEARLY.

WATER WELL RECORD  
KSA 82a-1201-1215

Kansas Department of Health and Environment-Division of Environment (Water well Contractors)  
Topeka, Kansas 66620

1. Location of well:		County <b>ELLIS</b>	Fraction <b>SE 1/4 SE 1/4 NW 34</b>	Section number <b>34</b>	Township number <b>T 13 S</b>	Range number <b>R 18 E/W</b>
2. Distance and direction from nearest town or city: Street address of well location if in city: <b>1702 Donald</b>			3. Owner of well: <b>Milton Dinger</b> R.R. or street: <b>1702 Donald</b> City, state, zip code: <b>Hays, Kansas 67601</b>			
4. Locate with "X" in section below: 		Sketch map: 		6. Bore hole dia. <b>9</b> in. Completion date <b>6/5/76</b> Well depth <b>40</b> ft.		
5. Type and color of material		From	To	7. Cable tool <input checked="" type="checkbox"/> Rotary <input type="checkbox"/> Driven <input type="checkbox"/> Dug <input type="checkbox"/> Hollow rod <input type="checkbox"/> Jetted <input type="checkbox"/> Bored <input type="checkbox"/> Reverse rotary		
Topsoil		0	5	8. Use: <input type="checkbox"/> Domestic <input type="checkbox"/> Public supply <input type="checkbox"/> Industry <input checked="" type="checkbox"/> Irrigation <input type="checkbox"/> Air conditioning <input type="checkbox"/> Stock <input checked="" type="checkbox"/> Lawn <input type="checkbox"/> Oil field water <input type="checkbox"/> Other		
Brown Clay		5	20	9. Casing: Material <b>PVC</b> Height: <b>Above</b> or below Threaded <input type="checkbox"/> Welded <input checked="" type="checkbox"/> Surface <b>15</b> in. RMP <input type="checkbox"/> PVC <input checked="" type="checkbox"/> Weight <b>2.8</b> lbs./ft. Dia. <b>5</b> in. to <b>40</b> ft. depth Wall Thickness: inches or Dia. <input type="checkbox"/> in. to <input type="checkbox"/> ft. depth gage No. <b>258</b>		
Medium Sand		20	35	10. Screen: Manufacturer's name <b>Jet Stream</b> Type <b>PVC</b> Dia. <b>5"</b> Slot/gauze <input type="checkbox"/> Length <b>10"</b> Set between <b>29</b> ft. and <b>39</b> ft. <input type="checkbox"/> ft. and <input type="checkbox"/> ft. Gravel pack? <input checked="" type="checkbox"/> Yes Size range of material <b>1/4"</b>		
Blue Shale		35	40	11. Static water level: <input type="checkbox"/> mo./day/yr. <b>30</b> ft. below land surface Date <b>6/5/76</b>		
				12. Pumping level below land surfaces: <b>30</b> ft. after <b>1</b> hrs. pumping <b>25</b> g.p.m. <input type="checkbox"/> ft. after <input type="checkbox"/> hrs. pumping <input type="checkbox"/> g.p.m. Estimated maximum yield <b>25</b> g.p.m.		
				13. Water sample submitted: <input type="checkbox"/> Yes <input checked="" type="checkbox"/> No Date <input type="checkbox"/>		
				14. Well head completion: <input type="checkbox"/> Pitless adapter <b>15</b> Inches above grade		
				<input checked="" type="checkbox"/> Well grouted? <b>Yes</b> With: <input type="checkbox"/> Neat cement <input type="checkbox"/> Bentonite <input checked="" type="checkbox"/> Concrete Depth: From <b>1</b> ft. to <b>9</b> ft.		
				16. Nearest source of possible contamination: <b>None</b> ft. <input type="checkbox"/> Direction <input type="checkbox"/> Type <input type="checkbox"/> Well disinfected upon completion? <input checked="" type="checkbox"/> Yes <input type="checkbox"/> No		
				17. Pump: <input type="checkbox"/> Not installed Manufacturer's name <b>F4W</b> Model number <b>58A8</b> HP <b>1/2</b> Volts <b>220</b> Length of drop pipe <b>35</b> ft. capacity <b>10</b> g.p.m. Type: <input checked="" type="checkbox"/> Submersible <input type="checkbox"/> Turbine <input type="checkbox"/> Jet <input type="checkbox"/> Reciprocating <input type="checkbox"/> Centrifugal <input type="checkbox"/> Other		
18. Elevation:		19. Remarks:				
Topography: <input type="checkbox"/> Hill <input checked="" type="checkbox"/> Slope <input type="checkbox"/> Upland <input type="checkbox"/> Valley		<b>None</b>  <input checked="" type="checkbox"/> Water well contractor's certification: This well was drilled under my jurisdiction and this report is true to the best of my knowledge and belief. 

Forward the white, blue and pink copies to the Department of Health and Environment

Form WWC-5