


LOCATION OF WATER WELL: Fraction EC 1/4 NW 1/4 NW 1/4 Section Number 34 Township Number T 13 S Range Number R 18 EW  
 County: Ellis

Distance and direction from nearest town or city street address of well if located within city?  
1322 Schwalbe Ave. Hays Ks. 67601

WATER WELL OWNER: DEAN Neuburger  
 RR#, St. Address, Box # : 1322 Schwalbe Ave. Board of Agriculture, Division of Water Resources  
 City, State, ZIP Code : Hays Ks. 67601 Application Number:

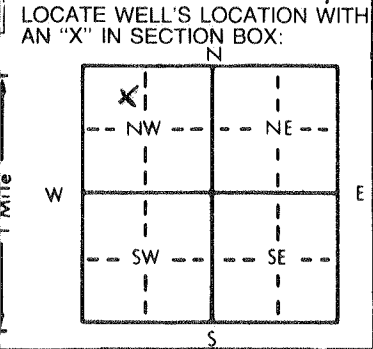

4 DEPTH OF COMPLETED WELL 47 ft. ELEVATION: ..... ft.  
 Depth(s) Groundwater Encountered 1. 32 ft. 2. .... ft. 3. .... ft.  
 WELL'S STATIC WATER LEVEL 29 ft. below land surface measured on mo/day/yr 3-14-91  
 Pump test data: Well water was 14 ft. after 1 hours pumping 16 gpm  
 Est. Yield 14 gpm: Well water was ..... ft. after ..... hours pumping ..... gpm  
 Bore Hole Diameter 1.0 in. to ..... ft., and ..... in. to ..... ft.  
 WELL WATER TO BE USED AS:  
 1 Domestic  3 Feedlot  6 Oil field water supply  9 Dewatering  12 Other (Specify below)  
 2 Irrigation  4 Industrial  7 Lawn and garden only  10 Monitoring well  
 Was a chemical/bacteriological sample submitted to Department? Yes ..... No ; If yes, mo/day/yr sample was submitted  
 Water Well Disinfected?  Yes  No

TYPE OF BLANK CASING USED:  
 1 Steel  3 RMP (SR)  5 Wrought iron  8 Concrete tile CASING JOINTS:  Glued  Clamped  
 2 PVC  4 ABS  6 Asbestos-Cement  9 Other (specify below)  Welded  
 3 Fiberglass  Threaded  
 Blank casing diameter ..... in. to ..... ft., Dia ..... in. to ..... ft., Dia ..... in. to ..... ft.  
 Casing height above land surface 18 in., weight ..... lbs./ft. Wall thickness or gauge No. SDR-26

TYPE OF SCREEN OR PERFORATION MATERIAL:  
 1 Steel  3 Stainless steel  5 Fiberglass  7 PVC  10 Asbestos-cement  
 2 Brass  4 Galvanized steel  6 Concrete tile  8 RMP (SR)  11 Other (specify) .....  
 12 None used (open hole)

SCREEN OR PERFORATION OPENINGS ARE:  
 1 Continuous slot  3 Mill slot  5 Gauzed wrapped  8 Saw cut  11 None (open hole)  
 2 Louvered shutter  4 Key punched  6 Wire wrapped  9 Drilled holes  
 7 Torch cut  10 Other (specify) .....

SCREEN-PERFORATED INTERVALS: From 27 ft. to 47 ft., From ..... ft. to ..... ft.  
 From ..... ft. to ..... ft., From ..... ft. to ..... ft.  
 GRAVEL PACK INTERVALS: From 25 ft. to 47 ft., From ..... ft. to ..... ft.  
 From ..... ft. to ..... ft., From ..... ft. to ..... ft.

GROUT MATERIAL:  1 Neat cement  2 Cement grout  3 Bentonite  4 Other .....  
 Grout Intervals: From 1 ft. to 21 ft., From ..... ft. to ..... ft., From ..... ft. to ..... ft.

What is the nearest source of possible contamination:  
 1 Septic tank  4 Lateral lines  7 Pit privy  10 Livestock pens  14 Abandoned water well  
 2 Sewer lines  5 Cess pool  8 Sewage lagoon  11 Fuel storage  15 Oil well/Gas well  
 3 Watertight sewer lines  6 Seepage pit  9 Feedyard  12 Fertilizer storage  16 Other (specify below)  
 13 Insecticide storage

Direction from well? EAST How many feet? 10

FROM	TO	LITHOLOGIC LOG	FROM	TO	PLUGGING INTERVALS
0	10	Top soil			
10	32	brown clay			
32	45	layers of med to fine grey sand mixed with layers of brown clay			
45	47	shale			

CONTRACTOR'S OR LANDOWNER'S CERTIFICATION: This water well was  (1) constructed, (2) reconstructed, or (3) plugged under my jurisdiction and was completed on (mo/day/year) 3-14-91 and this record is true to the best of my knowledge and belief. Kansas Water Well Contractor's License No. 276 This Water Well Record was completed on (mo/day/yr) 3-14-91 under the business name of Hubb Water Well Drilling by (signature) Jahn Luce

INSTRUCTIONS: Use typewriter or ball point pen. PLEASE PRESS FIRMLY and PRINT clearly. Please fill in blanks, underline or circle the correct answers. Send top three copies to Kansas Department of Health and Environment, Bureau of Water, Topeka, Kansas 66620-7320. Telephone: 913-296-5545. Send one to WATER WELL OWNER and retain one for your records.