


1] LOCATION OF WATER WELL: Fraction SE 1/4 SW 1/4 NW 1/4 Section Number 34 Township Number T 13 S Range Number R 18 E/W
 County: Ellis

Distance and direction from nearest town or city street address of well if located within city?
 1010 Downing Hays, Kansas

2] WATER WELL OWNER: H.D. Woods / Hays Professional Building
 RR#, St. Address, Box # : 1010 Downing Board of Agriculture, Division of Water Resources
 City, State, ZIP Code : Hays, Kansas 67601 Application Number:

3] LOCATE WELL'S LOCATION WITH AN "X" IN SECTION BOX: 4] DEPTH OF COMPLETED WELL... 80... ft. ELEVATION: ... Upland...

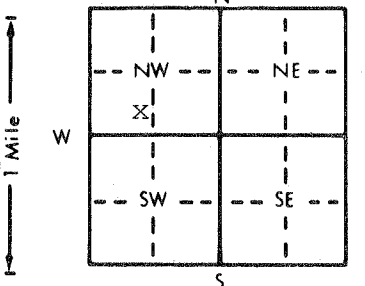

Depth(s) Groundwater Encountered 1... 65... ft. 2... ft. 3... ft.
 WELL'S STATIC WATER LEVEL ... 55... ft. below land surface measured on mo/day/yr ... 6/29/92...
 Pump test data: Well water was 54... ft. after 1... hours pumping 40... gpm
 Est. Yield 40... gpm: Well water was ... ft. after ... hours pumping ... gpm
 Bore Hole Diameter... 10... in. to 80... ft., and... in. to ... ft.
 WELL WATER TO BE USED AS: 7 5 Public water supply 8 Air conditioning 11 Injection well
 1 Domestic 3 Feedlot 6 Oil field water supply 9 Dewatering 12 Other (Specify below)
 2 Irrigation 4 Industrial 7 Lawn and garden only 10 Monitoring well
 Was a chemical/bacteriological sample submitted to Department? Yes.....No..X.....; If yes, mo/day/yr sample was sub-
 mitted Water Well Disinfected? Yes X No

5] TYPE OF BLANK CASING USED: 2 5 Wrought iron 8 Concrete tile CASING JOINTS: Glued X Clamped
 1 Steel 3 RMP (SR) 6 Asbestos-Cement 9 Other (specify below) Welded
 2 PVC 4 ABS 7 Fiberglass Threaded

Blank casing diameter ... 5... in. to 60... ft., Dia ... in. to ... ft., Dia ... in. to ... ft.
 Casing height above land surface ... 24... in., weight ... 2.29... lbs./ft. Wall thickness or gauge No. ... 26...

TYPE OF SCREEN OR PERFORATION MATERIAL: 7 7 PVC 10 Asbestos-cement
 1 Steel 3 Stainless steel 5 Fiberglass 8 RMP (SR) 11 Other (specify)
 2 Brass 4 Galvanized steel 6 Concrete tile 9 ABS 12 None used (open hole)

SCREEN OR PERFORATION OPENINGS ARE: 8 5 Gauzed wrapped 8 Saw cut 11 None (open hole)
 1 Continuous slot 3 Mill slot 6 Wire wrapped 9 Drilled holes
 2 Louvered shutter 4 Key punched 7 Torch cut 10 Other (specify)

SCREEN-PERFORATED INTERVALS: From ... 80... ft. to ... 60... ft., From ... ft. to ... ft.
 From ... ft. to ... ft., From ... ft. to ... ft.
 GRAVEL PACK INTERVALS: From ... 20... ft. to ... 80... ft., From ... ft. to ... ft.
 From ... ft. to ... ft., From ... ft. to ... ft.

6] GROUT MATERIAL: 3 1 Neat cement 2 Cement grout 3 Bentonite 4 Other
 Grout Intervals: From ... 0... ft. to ... 20... ft., From ... ft. to ... ft., From ... ft. to ... ft.

What is the nearest source of possible contamination: None
 1 Septic tank 4 Lateral lines 7 Pit privy 10 Livestock pens 14 Abandoned water well
 2 Sewer lines 5 Cess pool 8 Sewage lagoon 11 Fuel storage 15 Oil well/Gas well
 3 Watertight sewer lines 6 Seepage pit 9 Feedyard 12 Fertilizer storage 16 Other (specify below)
 13 Insecticide storage

Direction from well? How many feet?

FROM	TO	LITHOLOGIC LOG	FROM	TO	PLUGGING INTERVALS
0	4	Topsoil			
4	40	Gumbo clay			
40	43	Sandy clay			
43	45	Sand			
45	62	Gumbo clay			
62	65	Sandy clay			
65	72	Sand			
72	80	Shale			

7] CONTRACTOR'S OR LANDOWNER'S CERTIFICATION: This water well was (1) constructed, (2) reconstructed, or (3) plugged under my jurisdiction and was completed on (mo/day/year) ... 6/29/92... and this record is true to the best of my knowledge and belief. Kansas Water Well Contractor's License No. ... 199... This Water Well Record was completed on (mo/day/yr) ... 7/22/92... under the business name of Karst Water Well Drilling & Service, Inc. by (signature) *McH...*