


1 LOCATION OF WATER WELL: County: Ellis Fraction: SW 1/4 SW 1/4 SW 1/4 Section Number: 36 Township Number: T 13 S Range Number: R 18 E/W

Distance and direction from nearest town or city street address of well if located within city? Miles East of Hays on 13th. From 13th and Canterbury Intersection

2 WATER WELL OWNER: Conrad Hoffman RR#, St. Address, Box #: Rt 1 City, State, ZIP Code: Hays KS Board of Agriculture, Division of Water Resources Application Number:

3 LOCATE WELL'S LOCATION WITH AN "X" IN SECTION BOX: 4 DEPTH OF COMPLETED WELL: 45ft ft. ELEVATION:

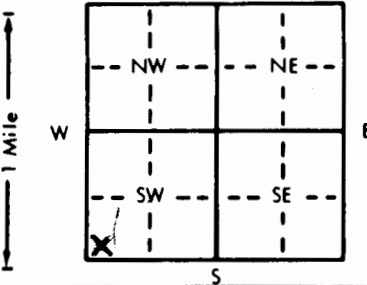

Depth(s) Groundwater Encountered 1. --- ft. 2. --- ft. 3. --- ft.
 WELL'S STATIC WATER LEVEL --- ft. below land surface measured on mo/day/yr
 Pump test data: Well water was --- ft. after --- hours pumping --- gpm
 Est. Yield dry gpm: Well water was --- ft. after --- hours pumping --- gpm
 Bore Hole Diameter: 10 1/4 in. to 45ft ft., and --- in. to --- ft.
 WELL WATER TO BE USED AS:
 1 Domestic 3 Feedlot 6 Oil field water supply 9 Dewatering 12 Other (Specify below)
 2 Irrigation 4 Industrial 7 Lawn and garden only 10 Observation well
 Was a chemical/bacteriological sample submitted to Department? Yes --- No X; If yes, mo/day/yr sample was submitted ---
 Water Well Disinfected? Yes --- No X

5 TYPE OF BLANK CASING USED: 1 Steel 3 RMP (SR) 5 Wrought iron 8 Concrete tile CASING JOINTS: Glued X Clamped ---
 2 PVC 4 ABS 6 Asbestos-Cement 9 Other (specify below) --- Welded ---
 7 Fiberglass 10 Asbestos-cement --- Threaded ---

Blank casing diameter: 5.56 in. to 15ft ft., Dia --- in. to --- ft., Dia --- in. to --- ft.
 Casing height above land surface: none in., weight --- lbs./ft. Wall thickness or gauge No. ---

TYPE OF SCREEN OR PERFORATION MATERIAL:
 1 Steel 3 Stainless steel 5 Fiberglass 8 RMP (SR) 11 Other (specify) ---
 2 Brass 4 Galvanized steel 6 Concrete tile 9 ABS 12 None used (open hole)

SCREEN OR PERFORATION OPENINGS ARE:
 1 Continuous slot 3 Mill slot 5 Gauzed wrapped 8 Saw cut 11 None (open hole)
 2 Louvered shutter 4 Key punched 6 Wire wrapped 9 Drilled holes 10 Other (specify) ---
 7 Torch cut

SCREEN-PERFORATED INTERVALS: From --- ft. to --- ft., From --- ft. to --- ft.
 GRAVEL PACK INTERVALS: From --- ft. to --- ft., From --- ft. to --- ft.

6 GROUT MATERIAL: 1 Neat cement 2 Cement grout 3 Bentonite 4 Other
 Grout Intervals: From 6 ft. to 3 ft., From --- ft. to --- ft., From --- ft. to --- ft.

What is the nearest source of possible contamination:
 1 Septic tank 4 Lateral lines 7 Pit privy 11 Fuel storage 14 Abandoned water well
 2 Sewer lines 5 Cess pool 8 Sewage lagoon 12 Fertilizer storage 15 Oil well/Gas well
 3 Watertight sewer lines 6 Seepage pit 9 Feedyard 13 Insecticide storage 16 Other (specify below) ---
 10 Livestock pens

Direction from well? Northeast How many feet? 250ft

FROM	TO	LITHOLOGIC LOG	FROM	TO	LITHOLOGIC LOG
45	15	sand & gravel			
15	6	clay back fill			
6	3	Cement grout			
3	0	Top soil			

7 CONTRACTOR'S OR LANDOWNER'S CERTIFICATION: This water well was (1) constructed, (2) reconstructed, or (3) plugged under my jurisdiction and was completed on (mo/day/year) 5/6/84 and this record is true to the best of my knowledge and belief. Kansas Water Well Contractor's License No. 455 This Water Well Record was completed on (mo/day/yr) 6/14/84 under the business name of Draw Pump Supply by (signature) James Becker

INSTRUCTIONS: Use typewriter or ball point pen, PLEASE PRESS FIRMLY and PRINT clearly. Please fill in blanks, underline or circle the correct answers. Send top three copies to Kansas Department of Health and Environment, Division of Environment, Environmental Geology Section, Topeka, KS 66620. Send one to WATER WELL OWNER and retain one for your records.