


WATER WELL RECORD Form WWC-5 KSA 82a-1212

1 LOCATION OF WATER WELL: County: <u>ELLIS</u>	Fraction <u>NE 1/4 SW 1/4 SW 1/4</u>	Section Number <u>21</u>	Township Number <u>T 13 S</u>	Range Number <u>R 18 E/W</u>
--	---	-----------------------------	----------------------------------	---------------------------------

Distance and direction from nearest town or city street address of well if located within city?
1405 WASHINGTON CIRCLE HAYS KS

2 WATER WELL OWNER: RANDY PFEIFER
 RR#, St. Address, Box # : 1405 WASHINGTON CIRCLE
 City, State, ZIP Code : HAYS KS 67601

Board of Agriculture, Division of Water Resources
Application Number: _____

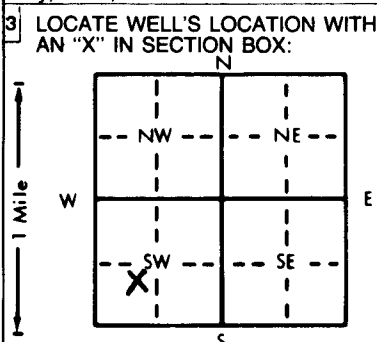

4 DEPTH OF COMPLETED WELL: 75 ft. ELEVATION: _____
 Depth(s) Groundwater Encountered 1. 50 ft. 2. _____ ft. 3. _____ ft.
 WELL'S STATIC WATER LEVEL 50 ft. below land surface measured on mo/day/yr 10-20-98
 Pump test data: Well water was _____ ft. after _____ hours pumping _____ gpm
 Est. Yield 10 gpm: Well water was _____ ft. after _____ hours pumping _____ gpm
 Bore Hole Diameter 10 in. to 7.5 ft., and _____ in. to _____ ft.
 WELL WATER TO BE USED AS:
 5 Public water supply 8 Air conditioning 11 Injection well
 1 Domestic 3 Feedlot 6 Oil field water supply 9 Dewatering 12 Other (Specify below)
 2 Irrigation 4 Industrial Lawn and garden only 10 Monitoring well _____
 Was a chemical/bacteriological sample submitted to Department? Yes _____ No ; If yes, mo/day/yr sample was submitted _____
 Water Well Disinfected? Yes _____ No

5 TYPE OF BLANK CASING USED:

1 Steel	3 RMP (SR)	5 Wrought iron	8 Concrete tile	CASING JOINTS: Glued <input checked="" type="checkbox"/> Clamped _____
<input checked="" type="checkbox"/> PVC	4 ABS	6 Asbestos-Cement	9 Other (specify below)	Welded _____
		7 Fiberglass		Threaded _____

Blank casing diameter 5 in. to 5.5 ft., Dia _____ in. to _____ ft., Dia _____ in. to _____ ft.
 Casing height above land surface 18 in., weight 160 lbs./ft. Wall thickness or gauge No. _____

TYPE OF SCREEN OR PERFORATION MATERIAL:

1 Steel	3 Stainless steel	5 Fiberglass	8 RMP (SR)	10 Asbestos-cement
2 Brass	4 Galvanized steel	6 Concrete tile	9 ABS	11 Other (specify) _____
				12 None used (open hole)

SCREEN OR PERFORATION OPENINGS ARE:

1 Continuous slot	<input checked="" type="checkbox"/> Mill slot	5 Gauzed wrapped	8 Saw cut	11 None (open hole)
2 Louvered shutter	4 Key punched	6 Wire wrapped	9 Drilled holes	
		7 Torch cut	10 Other (specify) _____	

SCREEN-PERFORATED INTERVALS: From 55 ft. to 75 ft., From _____ ft. to _____ ft.
 From _____ ft. to _____ ft., From _____ ft. to _____ ft.
GRAVEL PACK INTERVALS: From 30 ft. to 75 ft., From _____ ft. to _____ ft.
 From _____ ft. to _____ ft., From _____ ft. to _____ ft.

6 GROUT MATERIAL: 1 Neat cement 2 Cement grout Bentonite 4 Other _____
 Grout Intervals: From 0 ft. to 30 ft., From _____ ft. to _____ ft., From _____ ft. to _____ ft.

What is the nearest source of possible contamination:

1 Septic tank	4 Lateral lines	7 Pit privy	10 Livestock pens	14 Abandoned water well
2 Sewer lines	5 Cess pool	8 Sewage lagoon	11 Fuel storage	15 Oil well/Gas well
3 Watertight sewer lines	6 Seepage pit	9 Feedyard	12 Fertilizer storage	16 Other (specify below)
			13 Insecticide storage	

Direction from well? _____ How many feet? _____

FROM	TO	LITHOLOGIC LOG	FROM	TO	PLUGGING INTERVALS
0	10	SURFACE CLAY			
10	20	YELLOW CLAY			
20	32	MED SAND			
32	52	YELLOW CLAY			
52	62	SOFT YELLOW CLAY			
62	65	FINE SAND			
65	68	GRAY CLAY			
68	73	FINE SAND			
73	75	BLUE SHALE			

7 CONTRACTOR'S OR LANDOWNER'S CERTIFICATION: This water well was constructed, (2) reconstructed, or (3) plugged under my jurisdiction and was completed on (mo/day/year) 10-20-98 and this record is true to the best of my knowledge and belief. Kansas Water Well Contractor's License No. 444 This Water Well Record was completed on (mo/day/yr) 10-20-98 under the business name of ANDY ANDERSON DRILLING by (signature) Cindy Anderson

INSTRUCTIONS: Use typewriter or ball point pen. PLEASE PRESS FIRMLY and PRINT clearly. Please fill in blanks, underline or circle the correct answers. Send top three copies to Kansas Department of Health and Environment, Bureau of Water, Topeka, Kansas 66620-0001. Telephone: 913-296-5545. Send one to WATER WELL OWNER and retain one for your records.

OFFICE USE ONLY
T
R
EW
SEC
1/4
1/4
1/4