


1 LOCATION OF WATER WELL: Fraction **SE 1/4 SE 1/4 SE 1/4** Section Number **30** Township Number **T 13 S** Range Number **R 18 EW**
 County: **Ellis**

Distance and direction from nearest town or city street address of well if located within city?
W of River at Bird Feldt Farm, Hays

2 WATER WELL OWNER: **KDHE**
 RR#, St. Address, Box # **Bldg 740, Forbes Field** Board of Agriculture, Division of Water Resources
 City, State, ZIP Code **Topeka, Kansas 66620** Application Number:

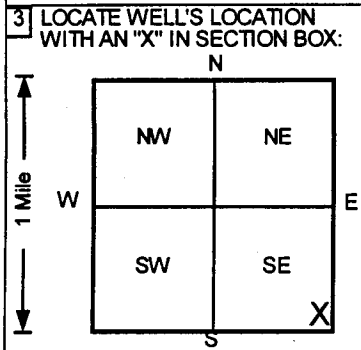

4 DEPTH OF COMPLETED WELL **45.5** ft. ELEVATION: ft.
 Depth(s) Groundwater Encountered 1. ft. 2. ft. 3. ft.
 WELL'S STATIC WATER LEVEL ft. below land surface measured on mo/day/yr
 Pump test data: Well water was **NA** ft. after hours pumping gpm
 Est. Yield **NA** gpm: Well water was ft. after hours pumping gpm
 Bore Hole Diameter **8** in. to **45.5** ft., and in. to ft.
 WELL WATER TO BE USED AS: 5 Public water supply 8 Air conditioning 11 Injection well
 1 Domestic 3 Feedlot 6 Oil field water supply 9 Dewatering 12 Other (Specify below)
 2 Irrigation 4 Industrial 7 Lawn and garden only **10** Monitoring well
 Was a chemical/bacteriological sample submitted to Department? Yes.....No.....; If yes, mo/day/yr sample was submitted
 Water Well Disinfected? Yes No

5 TYPE OF BLANK CASING USED: 5 Wrought iron 8 Concrete tile CASING JOINTS: Glued Clamped
 1 Steel 3 RMP (SR) 6 Asbestos-Cement 9 Other (specify below) Welded
2 PVC 4 ABS 7 Fiberglass Threaded.
 Blank casing diameter **2** in. to **24.5** ft. Dia. in. to ft. Dia. in. to ft.
 Casing height above land surface **0** in. weight **Sch 40** lbs./ft. Wall thickness or gauge No.
 TYPE OF SCREEN OR PERFORATION MATERIAL **7** PVC 10 Asbestos-cement
 1 Steel 3 Stainless steel 5 Fiberglass 8 RMP (SR) 11 Other (specify)
 2 Brass 4 Galvanized steel 6 Concrete tile 9 ABS 12 None used (open hole)
 SCREEN OR PERFORATION OPENINGS ARE: 5 Gauzed wrapped 8 Saw cut 11 None (open hole)
 1 Continuous slot **3** Mill slot 6 Wire wrapped 9 Drilled holes
 2 Louvered shutter 4 Key punched 7 Torch cut 10 Other (specify)
 SCREEN-PERFORATED INTERVALS: From **24.5** ft. to **44.5** ft. From ft. to ft.
 From ft. to ft. From ft. to ft.
 GRAVEL PACK INTERVALS: From **19.5** ft. to **45** ft. From ft. to ft.
 From ft. to ft. From ft. to ft.

6 GROUT MATERIAL: 1 Neat cement **2** Cement grout **3** Bentonite 4 Other
 Grout Intervals: From **0** ft. to **14** ft. From **14** ft. to **19.5** ft. From ft. to ft.
 What is the nearest source of possible contamination:
 1 Septic tank 4 Lateral lines 7 Pit privy 10 Livestock pens 14 Abandoned water well
 2 Sewer lines 5 Cess pool 8 Sewage lagoon 11 Fuel storage 15 Oil well/Gas well
 3 Watertight sewer lines 6 Seepage pit 9 Feedyard 12 Fertilizer storage **16** Other (specify below)
 13 Insecticide storage **Unknown**
 Direction from well? How many feet?

FROM	TO	LITHOLOGIC LOG	FROM	TO	PLUGGING INTERVALS
0	1	Clayey Silt, Dark Grayish Brown			
1	8	Silt,			
8	13	Sand,			
13	14.5	Silt,			
14.5	21	Sand,			
21	23	Sandy Clay,			
23	25	Sand,			
25	33	Clay, Dark Gray			
33	35	Clayey Sand,			
35	45	Sand,			
45	45.5	Shale, Black			
					MW15, Tag #, Flushmount
					Project Name: BM - Bird Feldt Farms
					GeoCore # 798, #

7 CONTRACTOR'S OR LANDOWNER'S CERTIFICATION: This water well was **1** constructed, **2** reconstructed, or **3** plugged under my jurisdiction and was completed on (mo/day/year) **5/25/99** and this record is true to the best of my knowledge and belief.
 Kansas Water Well Contractor's License No. **527** This Water Well Record was completed on (mo/day/yr) **7/10/99**
 under the business name of **GeoCore Services, Inc.** by (signature) *Bob Roll*

OFFICE USE ONLY
T
R
EW
SEC.
1/2
1/2