


1 LOCATION OF WATER WELL: Fraction NW 1/4 NW 1/4 NW 1/4 Section Number 32 Township Number T 13 S Range Number R 18 **EW**

Distance and direction from nearest town or city street address of well if located within city?

1/2 bl S of int. of Alt. Hwy183 & 27th St., Hays

2 WATER WELL OWNER: KDHE
 RR#, St Address, Box # : Bldg. 740, Forbes Field Board of Agriculture, Division of Water Resources
 City, State, ZIP Code : Topeka, Kansas 66620 Application Number:

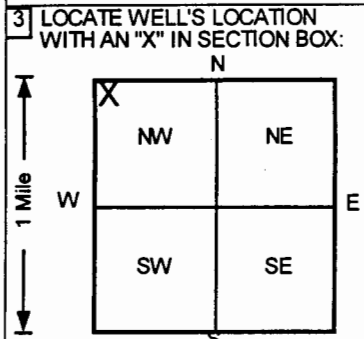

4 DEPTH OF COMPLETED WELL 43.5 ft ELEVATION: ft

Depth(s) Groundwater Encountered 1. ft 2. ft 3. ft

WELL'S STATIC WATER LEVEL ft below land surface measured on mo/day/yr

Pump test data: Well water was NA ft after hours pumping gpm

Est Yield NA gpm: Well water was ft after hours pumping gpm

Bore Hole Diameter 8 in. to 43.5 ft, and in. to ft

WELL WATER TO BE USED AS: 5 Public water supply 8 Air conditioning 11 Injection well
 1 Domestic 3 Feedlot 6 Oil field water supply 9 Dewatering 12 Other (Specify below)
 2 Irrigation 4 Industrial 7 Lawn and garden only **10** Monitoring well

Was a chemical/bacteriological sample submitted to Department? Yes.....No..... If yes, mo/day/yr sample was submitted Water Well Disinfected? Yes No

5 TYPE OF BLANK CASING USED: 5 Wrought iron 8 Concrete tile CASING JOINTS: Glued Clamped
 1 Steel 3 RMP (SR) 6 Asbestos-Cement 9 Other (specify below) Welded
2 PVC 4 ABS 7 Fiberglass Threaded.

Blank casing diameter 2 in. to 32 ft, Dia in. to ft, Dia in. to ft

Casing height above land surface 0 in., weight Sch 40 lbs./ft. Wall thickness or gauge No.

TYPE OF SCREEN OR PERFORATION MATERIAL **7** PVC 10 Asbestos-cement
 1 Steel 3 Stainless steel 5 Fiberglass 8 RMP (SR) 11 Other (specify)
 2 Brass 4 Galvanized steel 6 Concrete tile 9 ABS 12 None used (open hole)

SCREEN OR PERFORATION OPENINGS ARE: 5 Gauzed wrapped 8 Saw cut 11 None (open hole)
 1 Continuous slot **3** Mill slot 6 Wire wrapped 9 Drilled holes
 2 Louvered shutter 4 Key punched 7 Torch cut 10 Other (specify)

SCREEN-PERFORATED INTERVALS: From 32 ft to 42 ft, From ft to ft
 From ft to ft, From ft to ft

GRAVEL PACK INTERVALS: From 13 ft to 43 ft, From ft to ft
 From ft to ft, From ft to ft

6 GROUT MATERIAL: 1 Neat cement **2** Cement grout **3** Bentonite 4 Other

Grout Intervals: From 0 ft to 8 ft, From 8 ft to 13 ft, From ft to ft

What is the nearest source of possible contamination: 10 Livestock pens 14 Abandoned water well
 1 Septic tank 4 Lateral lines 7 Pit privy 11 Fuel storage 15 Oil well/Gas well
 2 Sewer lines 5 Cess pool 8 Sewage lagoon 12 Fertilizer storage **16** Other (specify below)
 3 Watertight sewer lines 6 Seepage pit 9 Feedyard 13 Insecticide storage Unknown

Direction from well? How many feet?

FROM	TO	LITHOLOGIC LOG	FROM	TO	PLUGGING INTERVALS
0	3	Clayey Silt, Dark Brown			
3	7	Yellowish Brown,			
7	19.5	Silt, Dark Brown			
19.5	22	Clay, Dark Brown			
22	31	Silt, Dark Brown			
31	33	Clayey Sand,			
33	35	Sand,			
35	36.5	Clay, Black			
36.5	43	Sand,			
43	43.5	Shale, Black			
					MW16, Tag #, Flushmount
					Project Name: BM - Bird Feldt Farms
					GeoCore # 798, #

7 CONTRACTOR'S OR LANDOWNER'S CERTIFICATION: This water well was **1** constructed, **2** reconstructed, or **3** plugged under my jurisdiction and was completed on (mo/day/year) 5/27/99 and this record is true to the best of my knowledge and belief.
 Kansas Water Well Contractor's License No. 527 This Water Well Record was completed on (mo/day/yr) 7/10/99
 under the business name of GeoCore Services, Inc. by (signature) *[Signature]*