


1] LOCATION OF WATER WELL:		Fraction	Section Number	Township Number	Range Number
County: ELLIS		SW 1/4 SW 1/4 SE 1/4	35	T 13 S	R 18 W

Distance and direction from nearest town or city street address of well if located within city?
 1702 COOPER CREEK

2] WATER WELL OWNER: MILT DINGES
 RR#, St. Address, Box #: 1702 COPPER CREEK
 City, State, ZIP Code: HAYS KS 67601
 Board of Agriculture, Division of Water Resources
 Application Number:

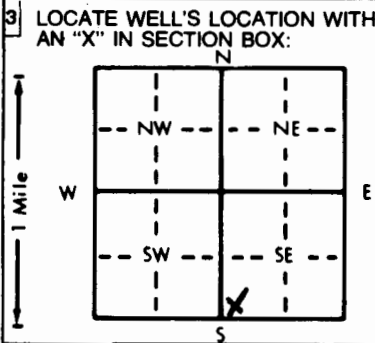

4] DEPTH OF COMPLETED WELL: 35 ft. ELEVATION:
 Depth(s) Groundwater Encountered 1. 20 ft. 2. ft. 3. ft.
 WELL'S STATIC WATER LEVEL: 20 ft. below land surface measured on mo/day/yr 11-8-99
 Pump test data: Well water was ft. after hours pumping gpm
 Est. Yield 25 gpm Well water was ft. after hours pumping gpm
 Bore Hole Diameter 10 in. to 35 ft. and in. to ft.
 WELL WATER TO BE USED AS:
 1 Domestic 3 Feedlot 5 Public water supply 8 Air conditioning 11 Injection well
 2 Irrigation 4 Industrial ~~X~~ Lawn and garden only 9 Dewatering 12 Other (Specify below)
 10 Monitoring well
 Was a chemical/bacteriological sample submitted to Department? Yes No ~~XX~~
 If yes, mo/day/yr sample was submitted
 Water Well Disinfected? Yes No ~~XX~~

5] TYPE OF BLANK CASING USED:
 1 Steel 3 RMP (SR) 5 Wrought iron 8 Concrete tile CASING JOINTS: Glued ~~XX~~ Clamped
~~X~~ PVC 4 ABS 6 Asbestos-Cement 9 Other (specify below) Welded
 7 Fiberglass Threaded
 Blank casing diameter 5 in. to 20 ft. Dia in. to ft. Dia in. to ft.
 Casing height above land surface 18 in., weight 160 lbs./ft. Wall thickness or gauge No.
 TYPE OF SCREEN OR PERFORATION MATERIAL:
 1 Steel 3 Stainless steel 5 Fiberglass 8 RMP (SR) 10 Asbestos-cement
 2 Brass 4 Galvanized steel 6 Concrete tile 9 ABS 11 Other (specify)
 12 None used (open hole)
 SCREEN OR PERFORATION OPENINGS ARE:
 1 Continuous slot ~~X~~ Mill slot 5 Gauzed wrapped 8 Saw cut 11 None (open hole)
 2 Louvered shutter 4 Key punched 6 Wire wrapped 9 Drilled holes
 7 Torch cut 10 Other (specify)
 SCREEN-PERFORATED INTERVALS: From 20 ft. to 35 ft. From ft. to ft.
 From ft. to ft. From ft. to ft.
 GRAVEL PACK INTERVALS: From 20 ft. to 35 ft. From ft. to ft.
 From ft. to ft. From ft. to ft.

6] GROUT MATERIAL: 1 Neat cement 2 Cement grout ~~X~~ Bentonite 4 Other
 Grout Intervals: From 0 ft. to 20 ft. From ft. to ft. From ft. to ft.
 What is the nearest source of possible contamination:
 1 Septic tank 4 Lateral lines 7 Pit privy 10 Livestock pens 14 Abandoned water well
 2 Sewer lines 5 Cess pool 8 Sewage lagoon 11 Fuel storage 15 Oil well/Gas well
 3 Watertight sewer lines 6 Seepage pit 9 Feedyard 12 Fertilizer storage 16 Other (specify below)
 13 Insecticide storage

Direction from well?		LITHOLOGIC LOG		PLUGGING INTERVALS	
FROM	TO	FROM	TO	FROM	TO
0	5				
		SURFACE CLAY			
5	18				
		hard YELLOW CLAY			
18	22				
		FINE SAND			
22	30				
		MED SAND			
30	35				
		SOAPSTONE			

7] CONTRACTOR'S OR LANDOWNER'S CERTIFICATION: This water well was ~~(1)~~ constructed, (2) reconstructed, or (3) plugged under my jurisdiction and was completed on (mo/day/year) 11-8-99 and this record is true to the best of my knowledge and belief. Kansas Water Well Contractor's License No. 444 This Water Well Record was completed on (mo/day/yr) 11-8-99 under the business name of ANDY ANDERSON DRILLING by (signature) Andy Anderson

OFFICE USE ONLY
T
R
EW
SEC.