


1 LOCATION OF WATER WELL: County: ELLIS	Fraction SE 1/4 SW 1/4 SW 1/4	Section Number 29	Township Number T 13 S	Range Number R 18 EW
--	----------------------------------	----------------------	---------------------------	-------------------------

Distance and direction from nearest town or city street address of well if located within city?
2704 1/2 THUNDERBIRD HAYS KS

2 WATER WELL OWNER: DONALD NAPELL
RR#, St. Address, Box #: 2704 1/2 THUNDERBIRD
City, State, ZIP Code: HAYS KS 67601
Board of Agriculture, Division of Water Resources
Application Number:

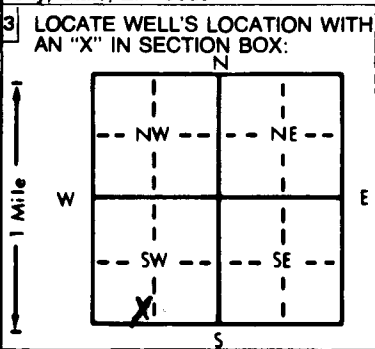

4 DEPTH OF COMPLETED WELL: 58 ft. ELEVATION: ...
Depth(s) Groundwater Encountered: 1. 42 ft. 2. ... ft. 3. ... ft.
WELL'S STATIC WATER LEVEL: 42 ft. below land surface measured on mo/day/yr 2-29-00
Pump test data: Well water was ... ft. after ... hours pumping ... gpm
Est. Yield: 30 gpm Well water was ... ft. after ... hours pumping ... gpm
Bore Hole Diameter: 10 in. to 58 in. to ... ft. and ... in. to ... ft.
WELL WATER TO BE USED AS:
5 Public water supply 8 Air conditioning 11 Injection well
1 Domestic 3 Feedlot 6 Oil field water supply 9 Dewatering 12 Other (Specify below)
2 Irrigation 4 Industrial XX Lawn and garden only 10 Monitoring well
Was a chemical/bacteriological sample submitted to Department? Yes.....No...XX; If yes, mo/day/yr sample was submitted
Water Well Disinfected? Yes No XX

5 TYPE OF BLANK CASING USED:
1 Steel 3 RMP (SR) 5 Wrought iron 8 Concrete tile CASING JOINTS: Glued XX Clamped
XX PVC 4 ABS 6 Asbestos-Cement 9 Other (specify below) Welded
7 Fiberglass Threaded
Blank casing diameter: 5 in. to 38 ft., Dia. ... in. to ... ft., Dia. ... in. to ... ft.
Casing height above land surface: 18 in., weight: 160 lbs./ft. Wall thickness or gauge No. ...
TYPE OF SCREEN OR PERFORATION MATERIAL:
1 Steel 3 Stainless steel 5 Fiberglass 8 RMP (SR) 10 Asbestos-cement
2 Brass 4 Galvanized steel 6 Concrete tile 9 ABS 11 Other (specify)
12 None used (open hole)
SCREEN OR PERFORATION OPENINGS ARE:
1 Continuous slot XX Mill slot 5 Gauzed wrapped 8 Saw cut 11 None (open hole)
2 Louvered shutter 4 Key punched 6 Wire wrapped 9 Drilled holes
3 38 7 Torch cut 10 Other (specify)
SCREEN-PERFORATED INTERVALS: From ... 38 ft. to ... 58 ft., From ... ft. to ... ft.
GRAVEL PACK INTERVALS: From ... 30 ft. to ... 58 ft., From ... ft. to ... ft.

6 GROUT MATERIAL: 1 Neat cement 2 Cement grout XX Bentonite 4 Other
Grout Intervals: From ... 0 ft. to ... 30 ft., From ... ft. to ... ft., From ... ft. to ... ft.
What is the nearest source of possible contamination:
1 Septic tank 4 Lateral lines 7 Pit privy 10 Livestock pens 14 Abandoned water well
2 Sewer lines 5 Cess pool 8 Sewage lagoon 11 Fuel storage 15 Oil well/Gas well
3 Watertight sewer lines 6 Seepage pit 9 Feedyard 12 Fertilizer storage 16 Other (specify below)
13 Insecticide storage
Direction from well? How many feet?

FROM	TO	LITHOLOGIC LOG	FROM	TO	PLUGGING INTERVALS
0	3	SURFACE CLAY			
3	25	GRAY CLAY			
25	35	BLUE CLAY			
35	40	FINE SAND			
40	45	MED SAND			
45	55	LARGE SAND			
55	58	BLUE SHALE			

7 CONTRACTOR'S OR LANDOWNER'S CERTIFICATION: This water well was XX constructed, (2) reconstructed, or (3) plugged under my jurisdiction and was completed on (mo/day/year) 2-29-00 and this record is true to the best of my knowledge and belief. Kansas Water Well Contractor's License No. 444 This Water Well Record was completed on (mo/day/yr) 2-29-00 under the business name of ANDY ANDERSON DRILLING by (signature) Andy Anderson

OFFICE USE ONLY
T
R
EW
SEC.
1/4
1/4